

Form AI-187
March 1961

UNITED STATES
DEPARTMENT OF THE INTERIOR
BUREAU OF LAND MANAGEMENT


SECTION

8

Oregon State Water Filings

TOWNSHIP 24S, RANGE 26E, W. M.

North

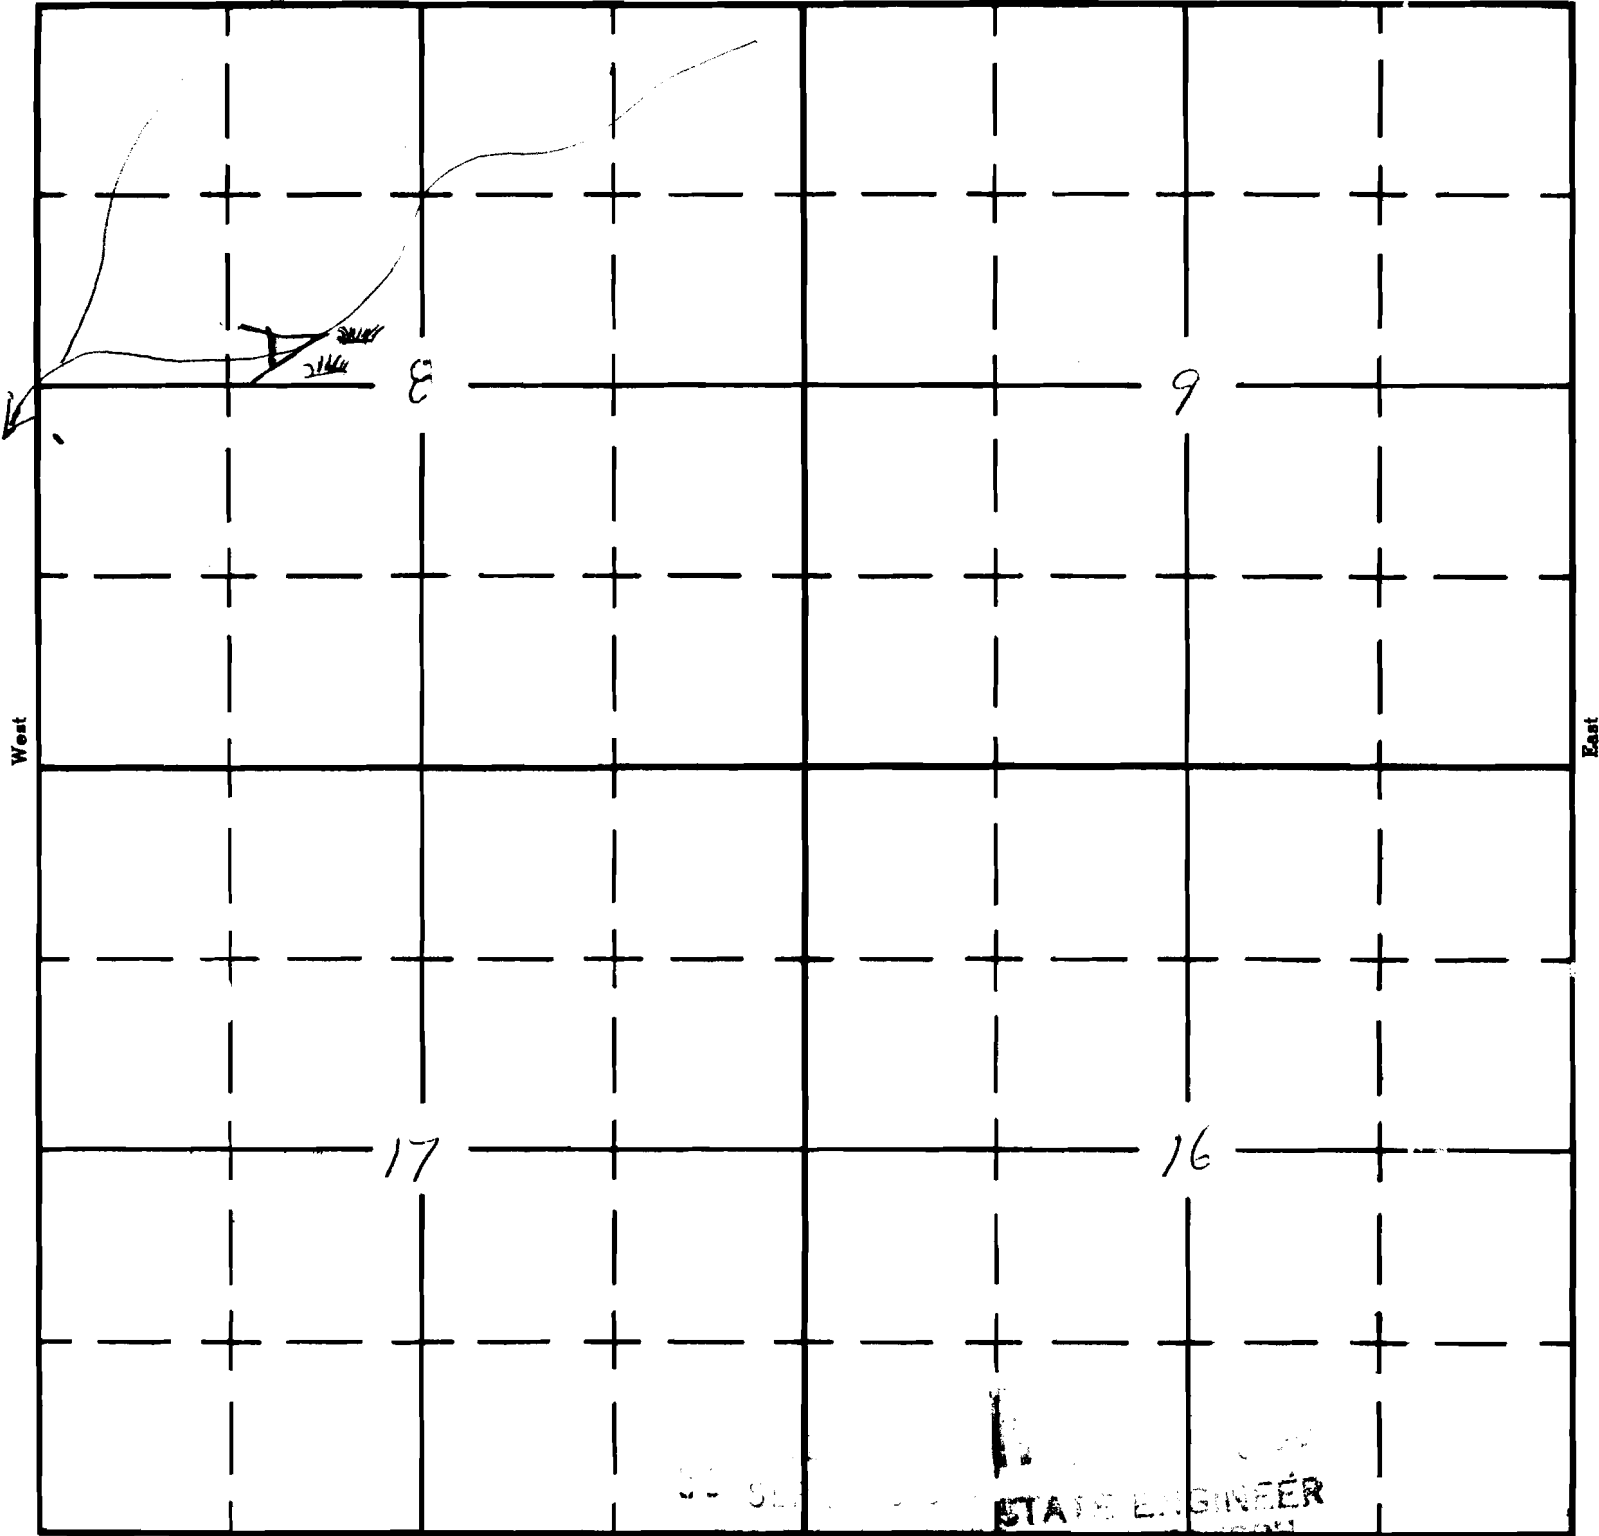

South

APPLICATION No. E-39031
PERMIT No. R 7621