

Form AI-187
March 1961


UNITED STATES
DEPARTMENT OF THE INTERIOR
BUREAU OF LAND MANAGEMENT

SECTION

Oregon State Water Filings

TOWNSHIP ²⁴~~23~~ S, RANGE ²⁸~~27~~ E, W. M.

North

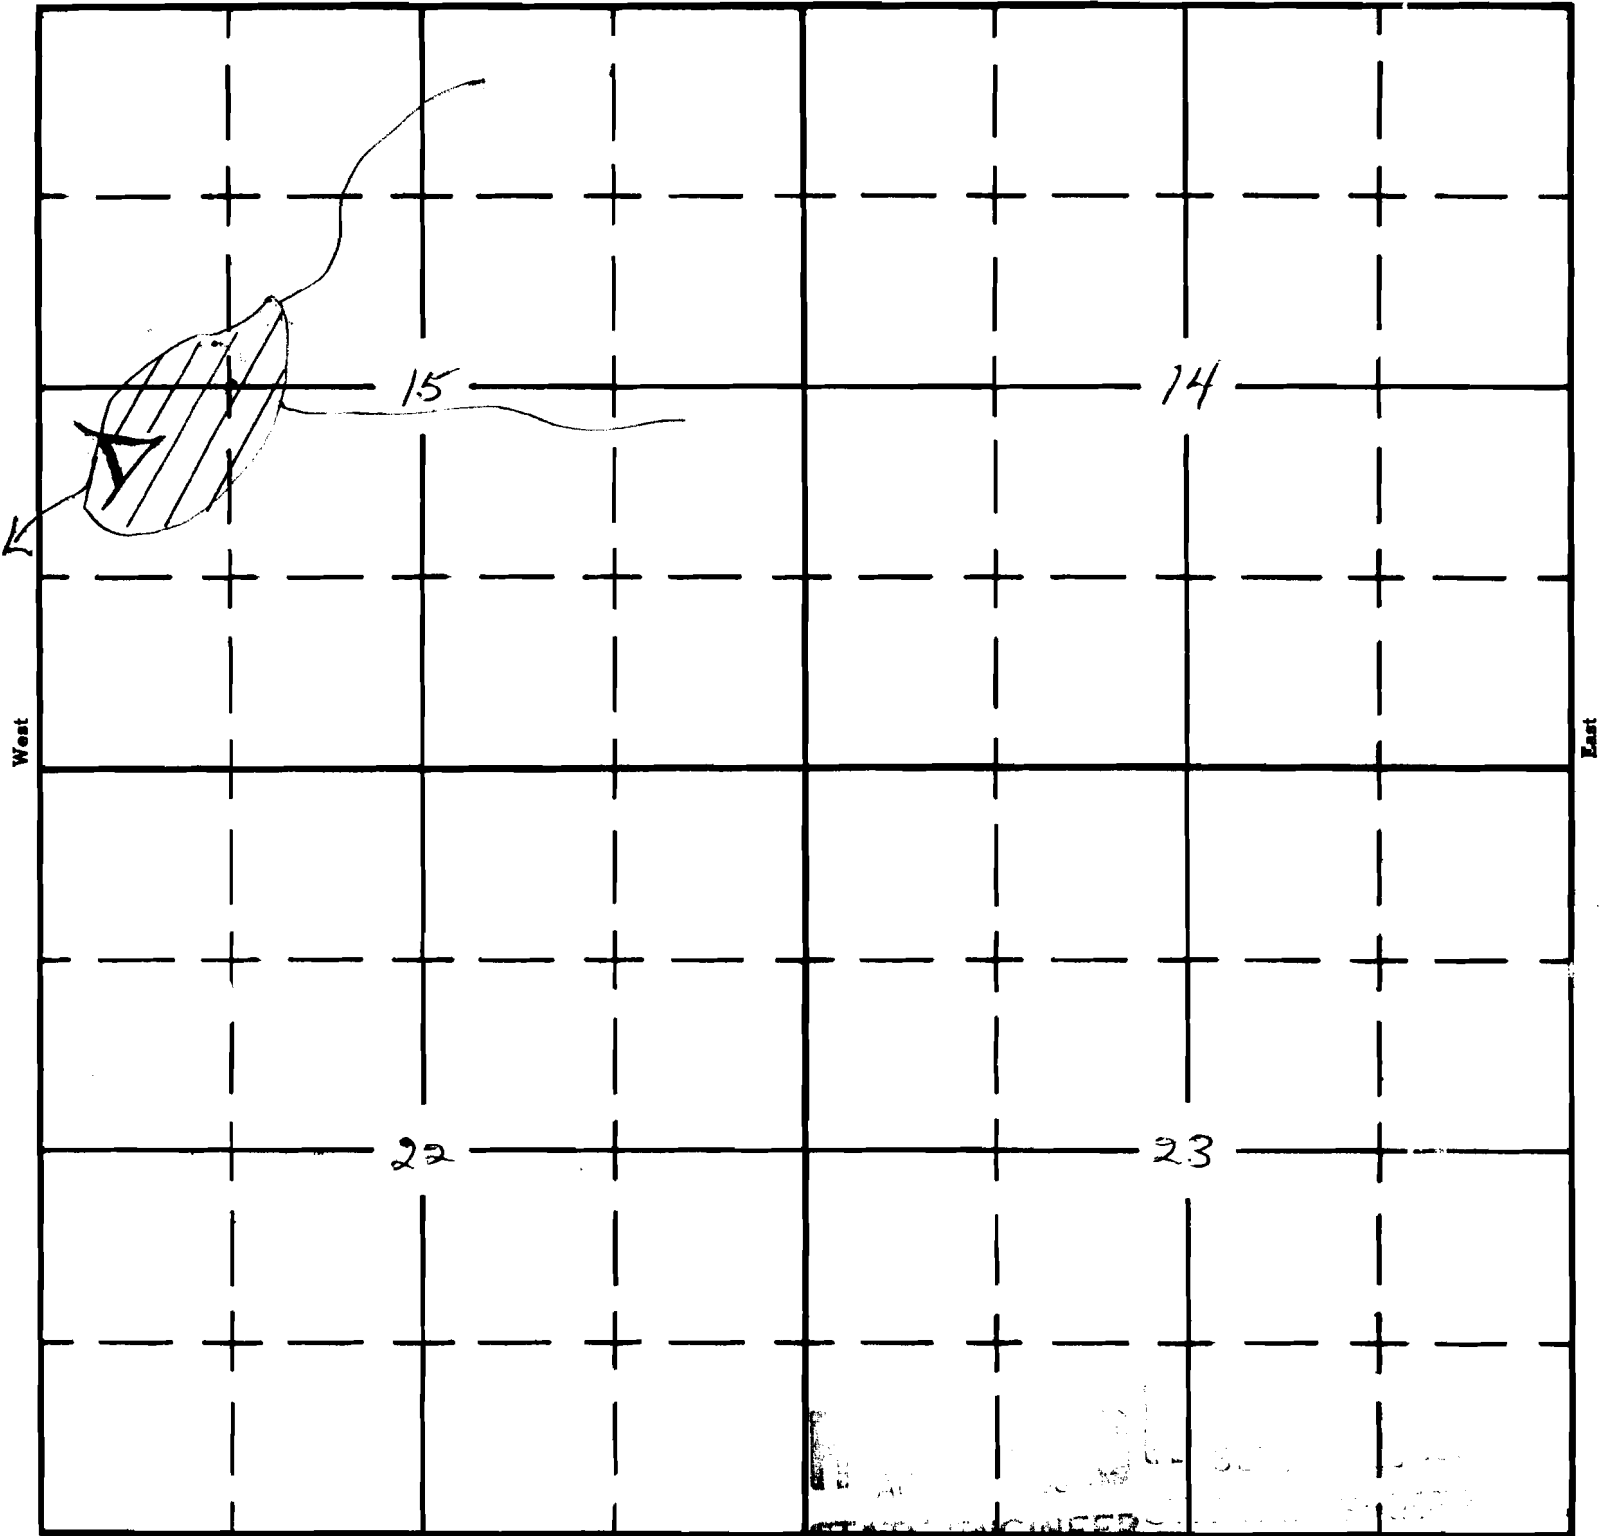

South

STATE ENGINEER
SALEM, OREGON

APPLICATION No. R-39033
PERMIT No. R 7622