

UNITED STATES
DEPARTMENT OF THE INTERIOR
BUREAU OF LAND MANAGEMENT

SECTION

Oregon State Water Filings

NW 1/4 SW 1/4

TOWNSHIP 32 S, RANGE 3 E, W. M.


Sec. 13

RECEIVED
JUN 20 1965
STATE LAND DEPT.

North

West

East

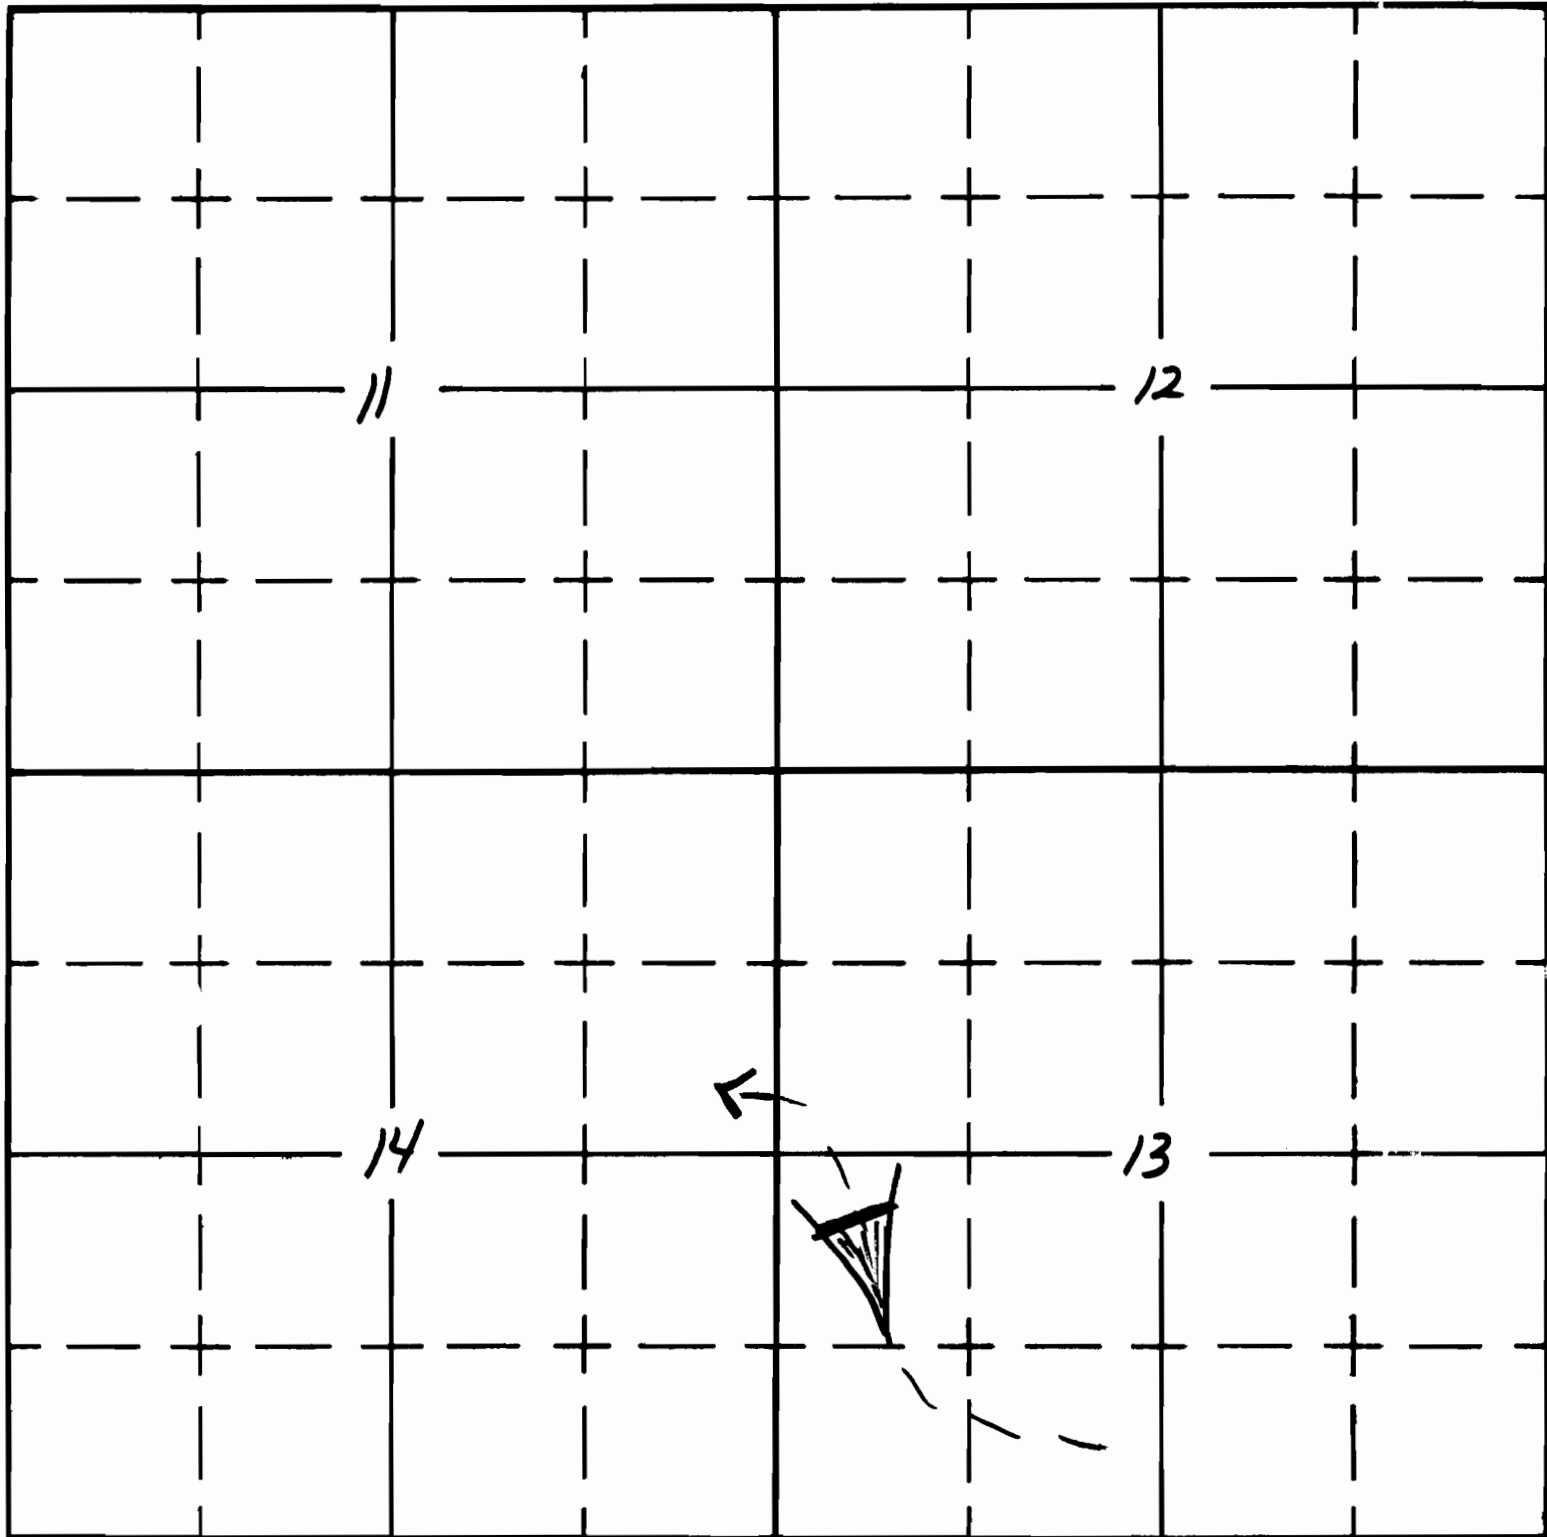

South

APPLICATION No. R-41167
PERMIT No. 7626

Form A1-187
March 1961

UNITED STATES
DEPARTMENT OF THE INTERIOR
BUREAU OF LAND MANAGEMENT

RECEIVED

SECTION

Oregon State Water Filings

JAN 22 1985

WATER RESOURCES DEPT


SALEM, OREGON

STATE ENGINEER
DALE J. JOHNSON

TOWNSHIP 32 S, RANGE 3 E, W. M.

~~Section 14~~
SW SW
Sec. 13

North

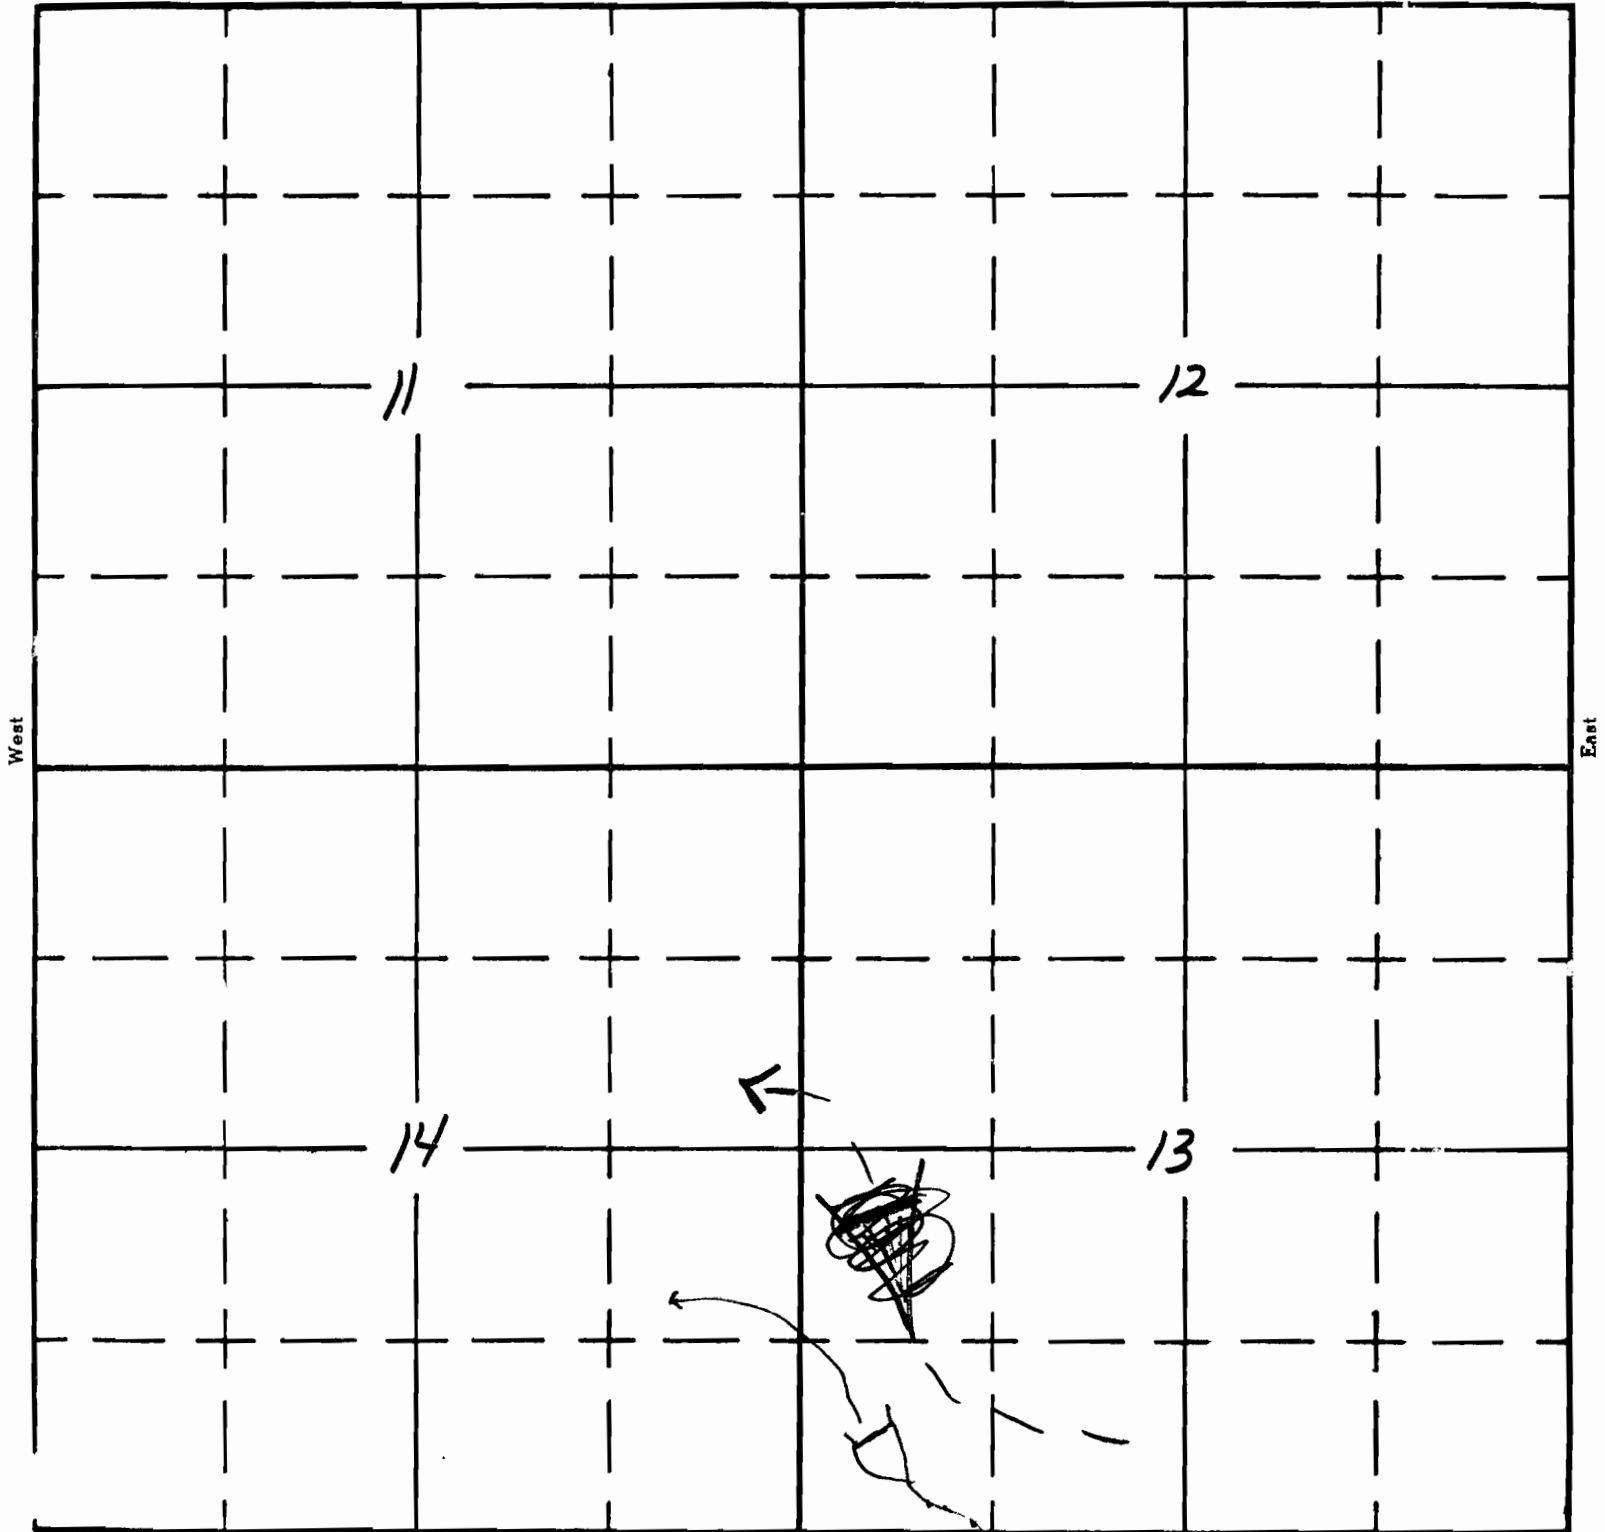

South

APPLICATION No. R-41167
PERMIT No. 7626