Form A1-187
March 1961


UNITED STATES
DEPARTMENT OF THE INTERIOR
BUREAU OF LAND MANAGEMENT

SECTION

Oregon State Water Filings

SE¼ NW¼ TOWNSHIP 23 S., RANGE 28 E., W. M.
Sec. 8

North

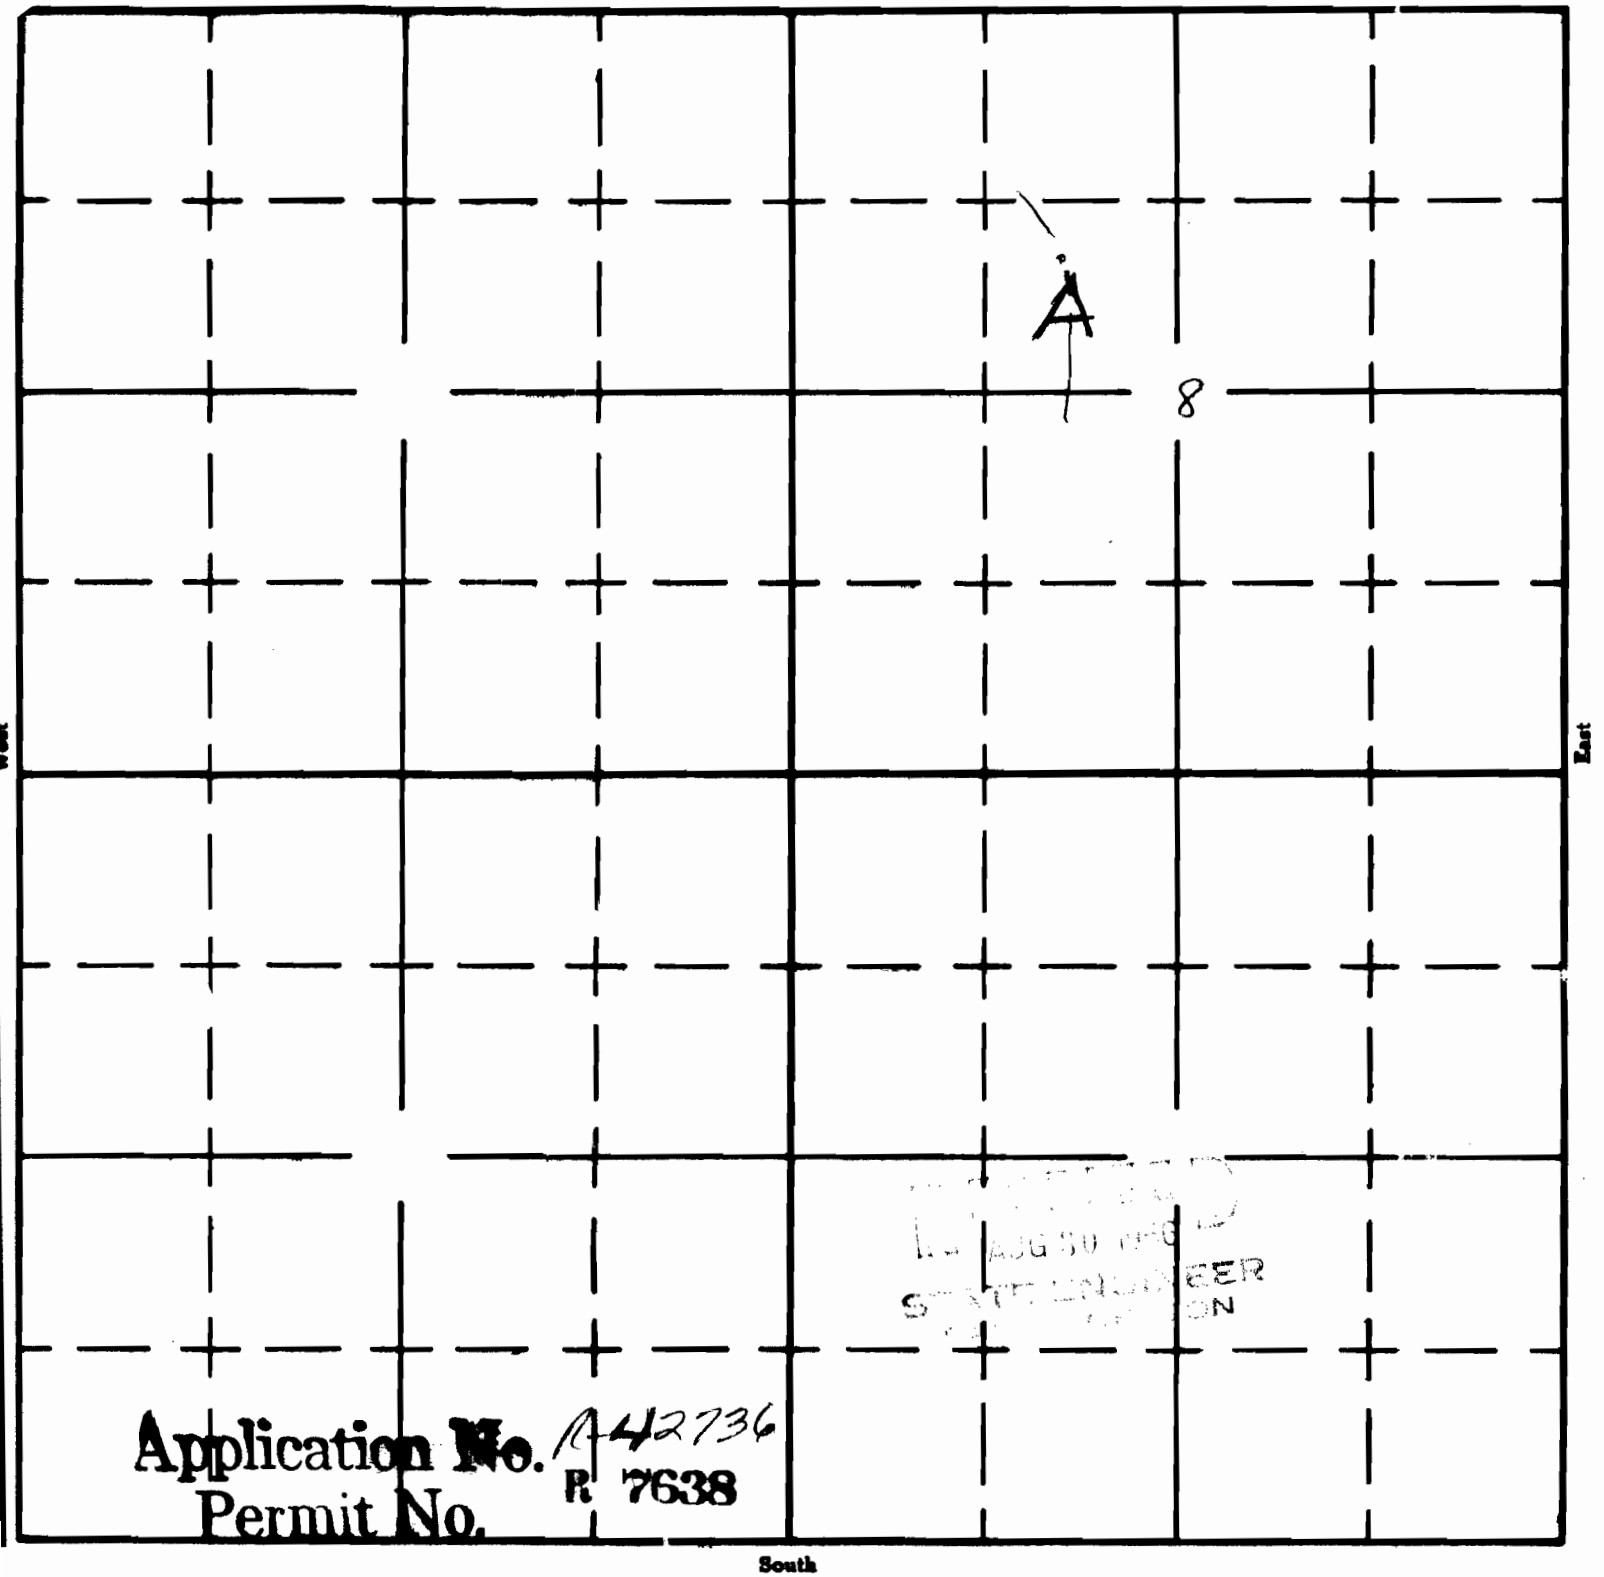

West

East

South

Application No. R42736
Permit No. R 7638

APPLICATION No.
PERMIT No.