

UNITED STATES
DEPARTMENT OF THE INTERIOR
BUREAU OF LAND MANAGEMENT

SECTION


SE 1/4 NW 1/4 Sec 3

Oregon State Water Filings

TOWNSHIP 20S, RANGE 21E, W. M.


North

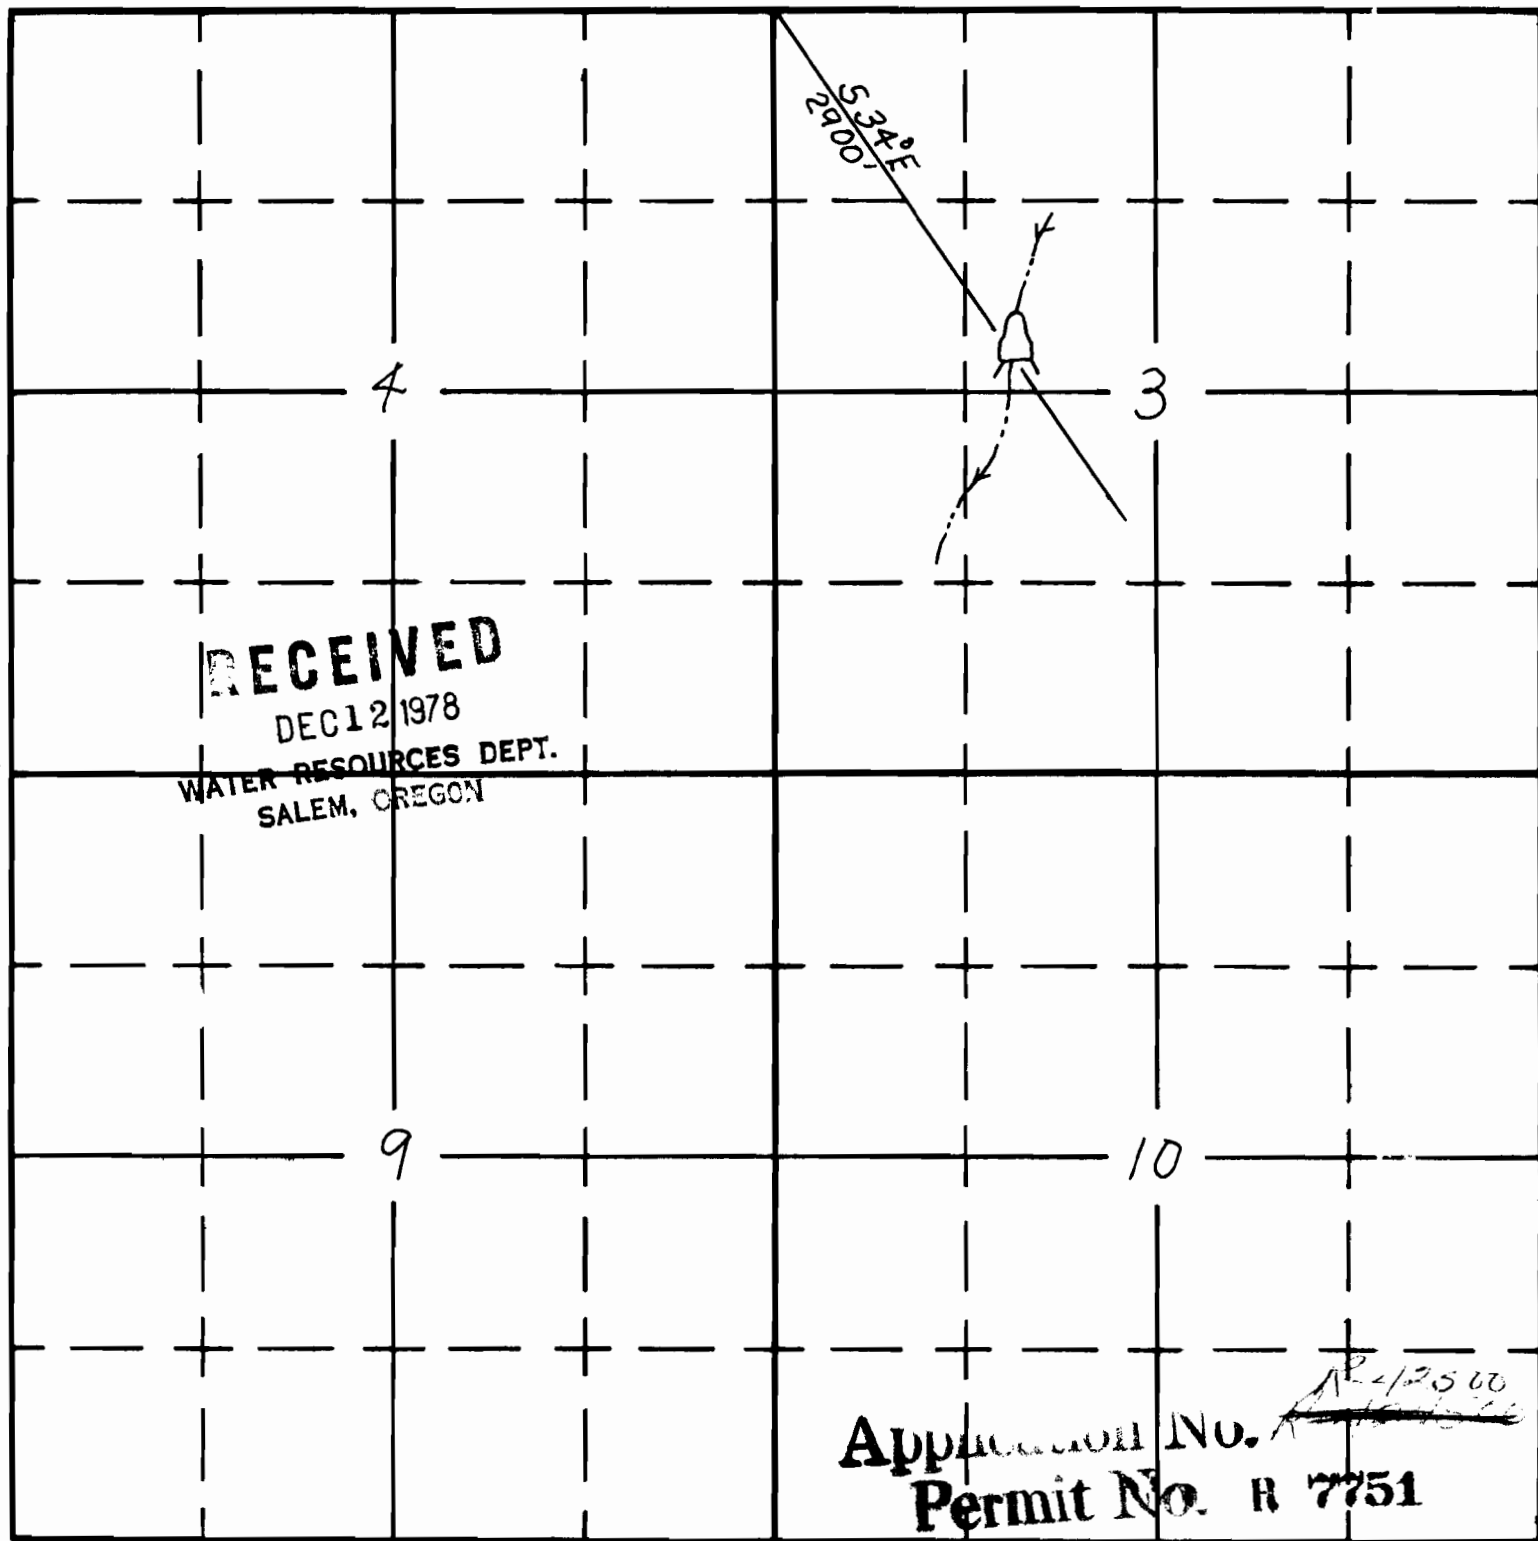

RECEIVED
DEC 12 1978
WATER RESOURCES DEPT.
SALEM, OREGON

Application No. 12-2500
Permit No. R 7751

South Clover Res. #2
05-R-253

South

APPLICATION No.
PERMIT No.