

UNITED STATES
DEPARTMENT OF THE INTERIOR
BUREAU OF LAND MANAGEMENT


SECTION

Oregon State Water Filings

SW 1/4 SE 1/4 Sec 24

TOWNSHIP 19S, RANGE 20E, W. M.

North

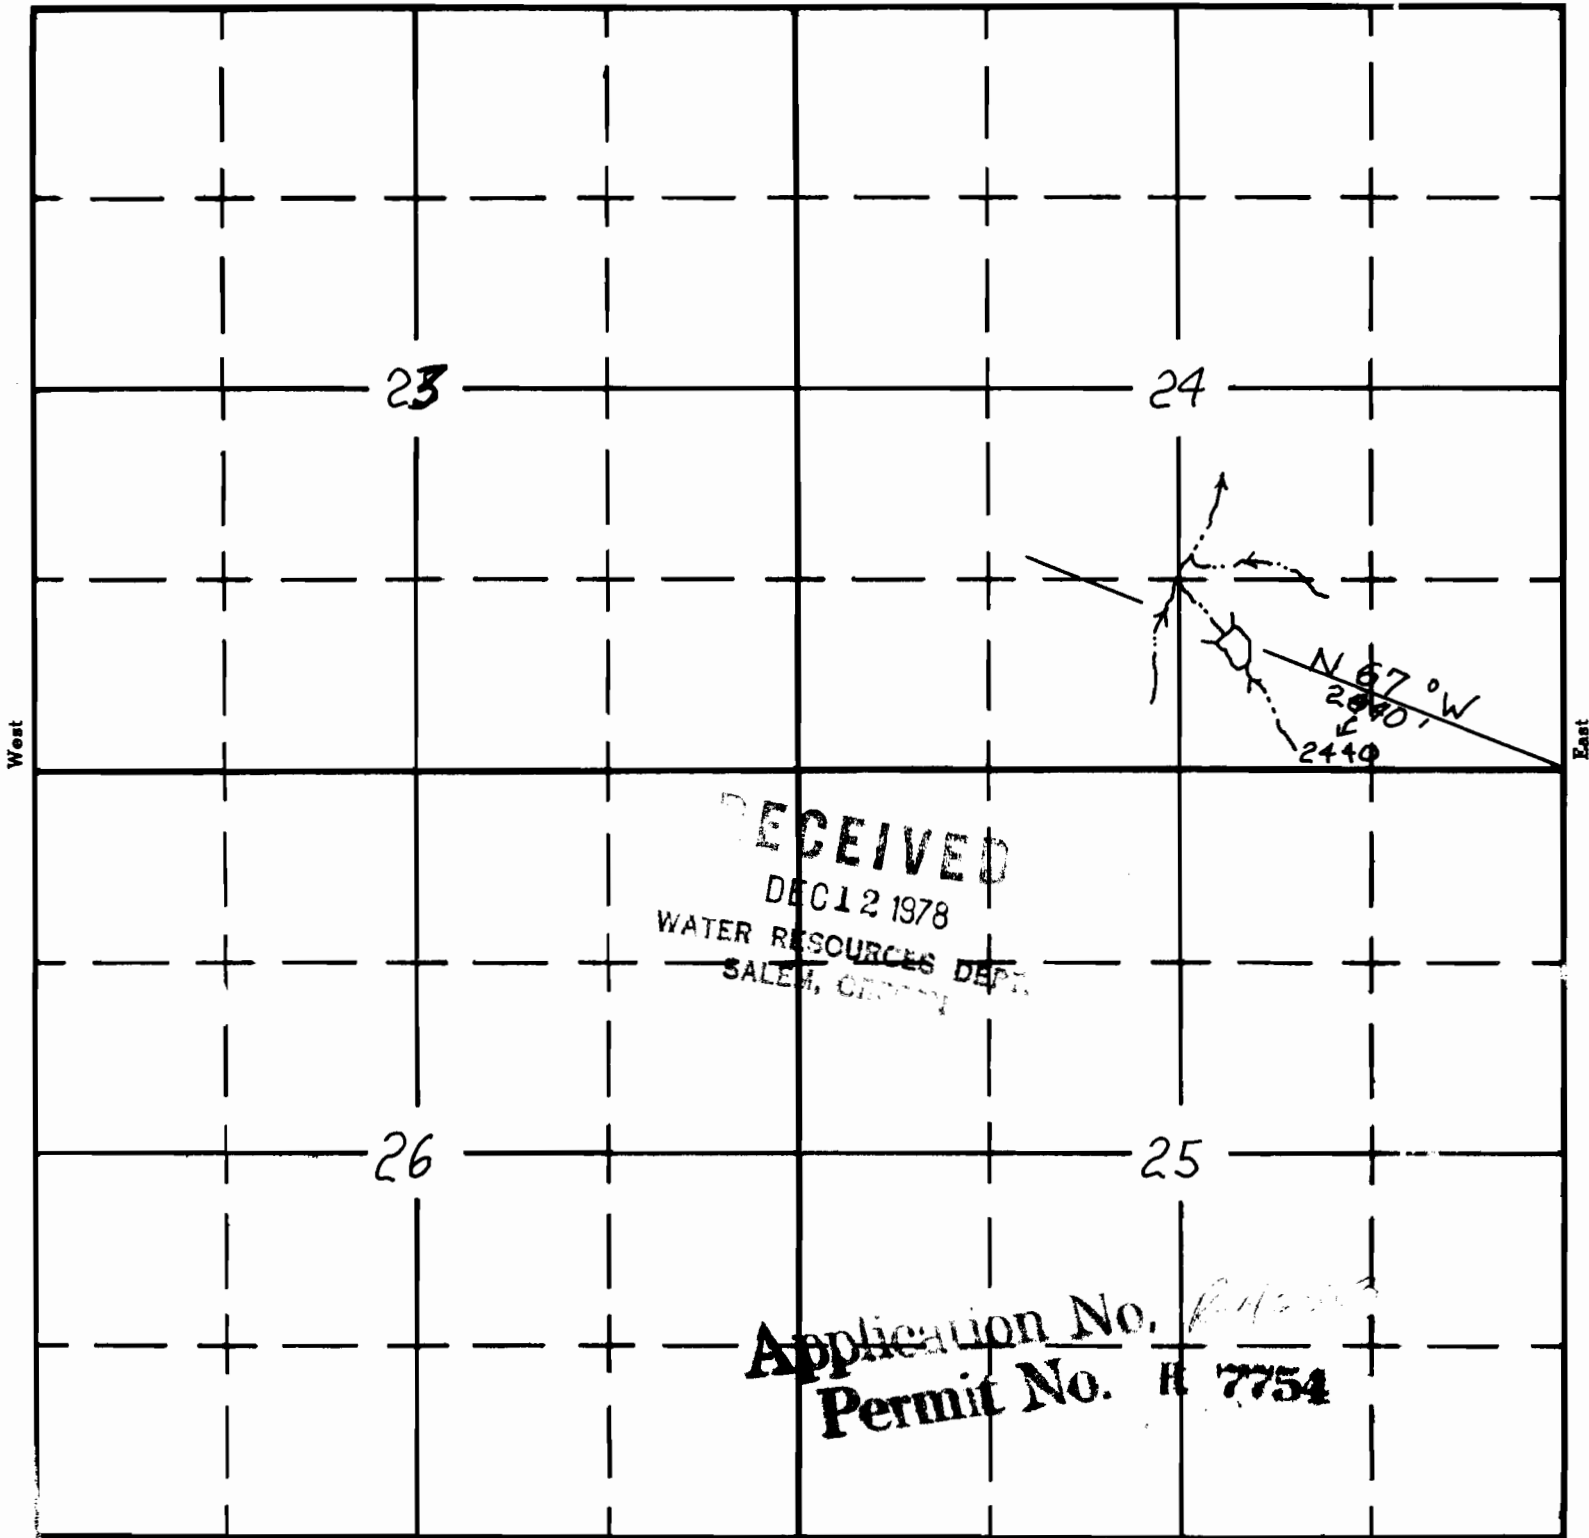

South

Ole Res.
05-R-263

APPLICATION No.
PERMIT No.