

UNITED STATES
DEPARTMENT OF THE INTERIOR
BUREAU OF LAND MANAGEMENT


SECTION

Oregon State Water Filings

SE 1/4 SW 1/4 Sec 21

TOWNSHIP 19S, RANGE 20E, W. M.

North

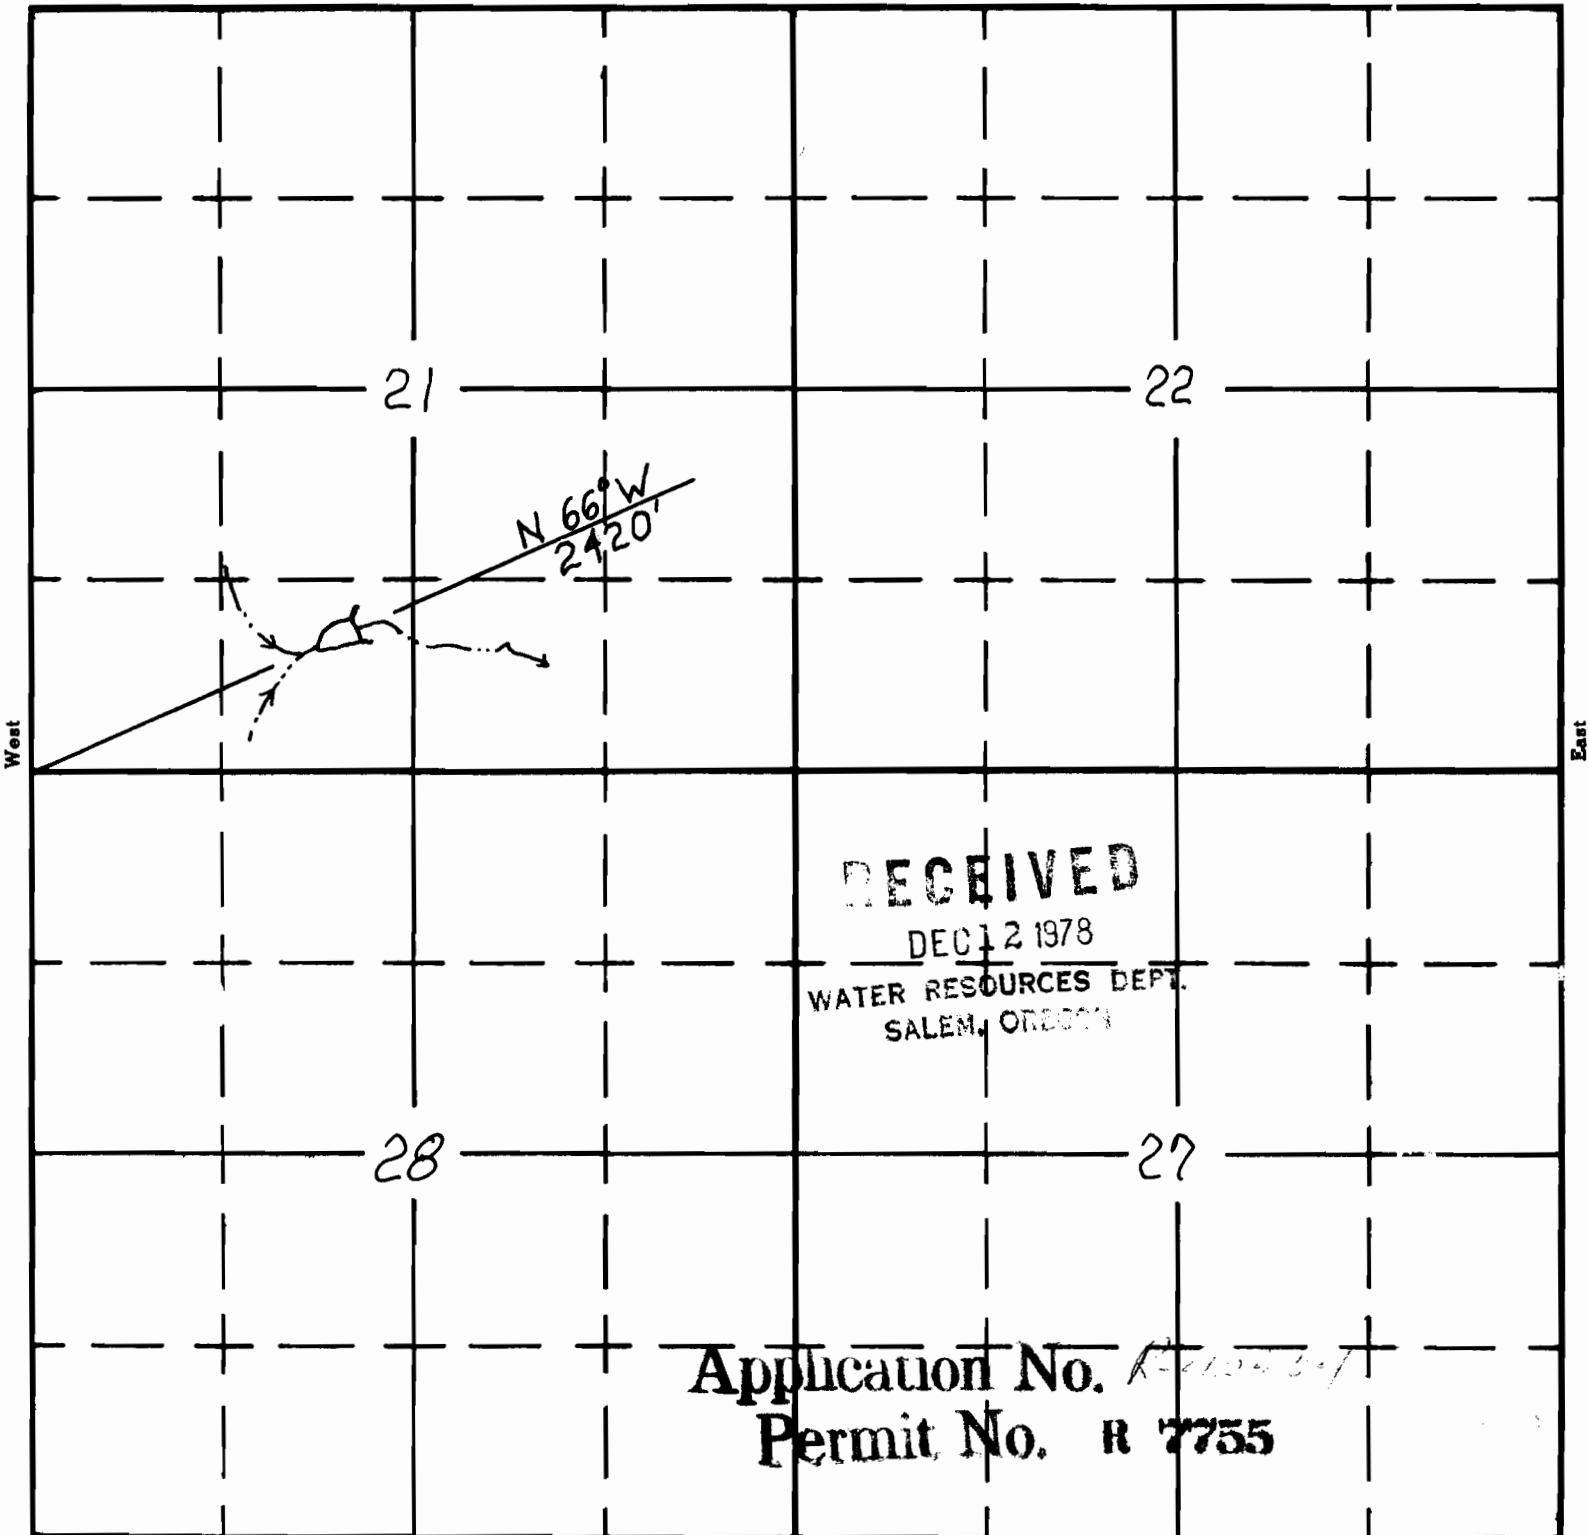

Bench Res. #1
05-R-257

South

APPLICATION No.
PERMIT No.