

P-5430-2
Nov. 1964


UNITED STATES
DEPARTMENT OF THE INTERIOR
BUREAU OF LAND MANAGEMENT

SECTION DIAGRAM

MAP CONTRACT No. 14-11-0001()-

T. 19 S. R. 18 E. Sec. 22, Will. Mer. Prineville DISTRICT

MAPPER DATE

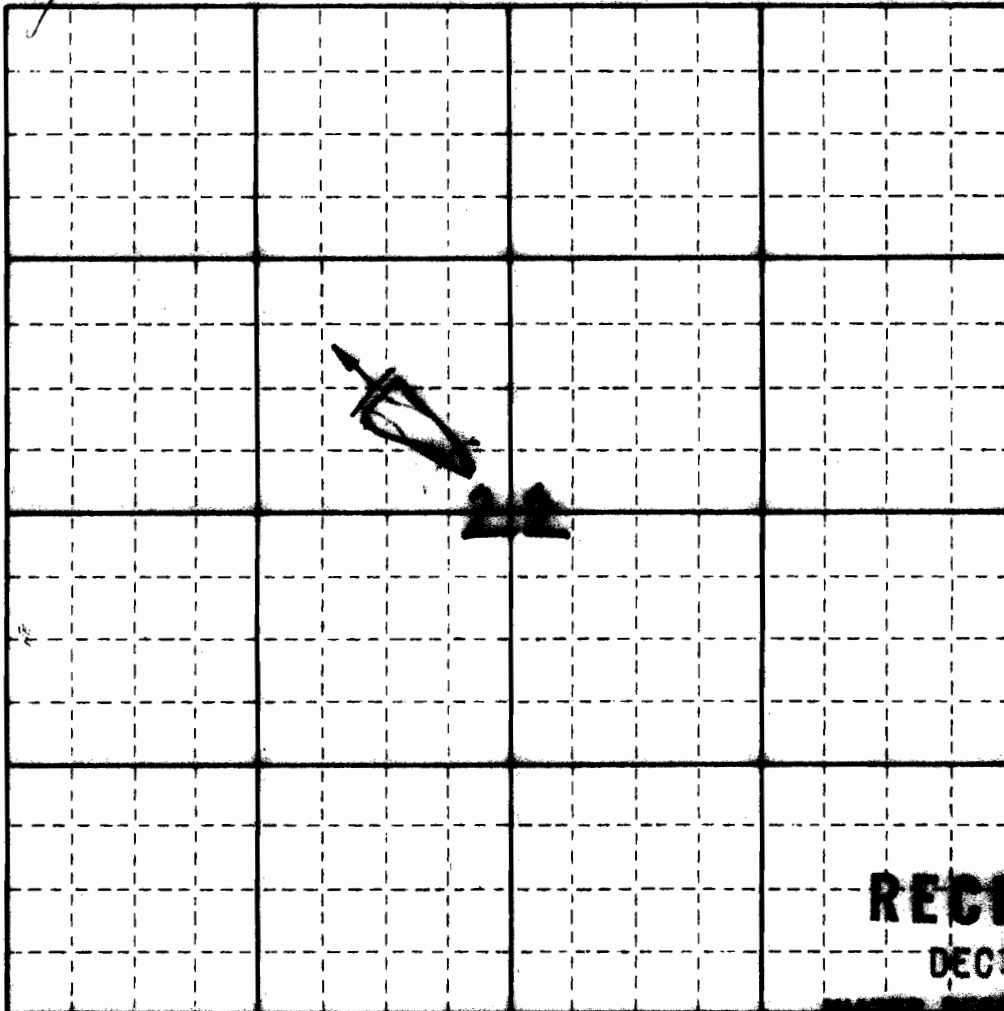

RECEIVED

DEC 12 1978

WATER RESOURCES DEPT.
SALEM, OREGON

SCALE: 1" = 1,000 FT.

LEGEND

☐
☐
☐
☐
☐

RECEIVED

NOV 14 1973

STATE ENGINEER
SALEM, OREGON

=====

MAINLINE ROAD

=====

PROPOSED SPUR ROADS

YARDING ROADS (CAT OR HIGH LEAD)

●

SPUR TREES (YARDING OR LOADING)

●

CORNERS FOUND

BOUNDARY - CONTRACT AREA

=====

BOUNDARY - CUTTING AREA