



Application No. R-62972

Permit No. R 8432

63192

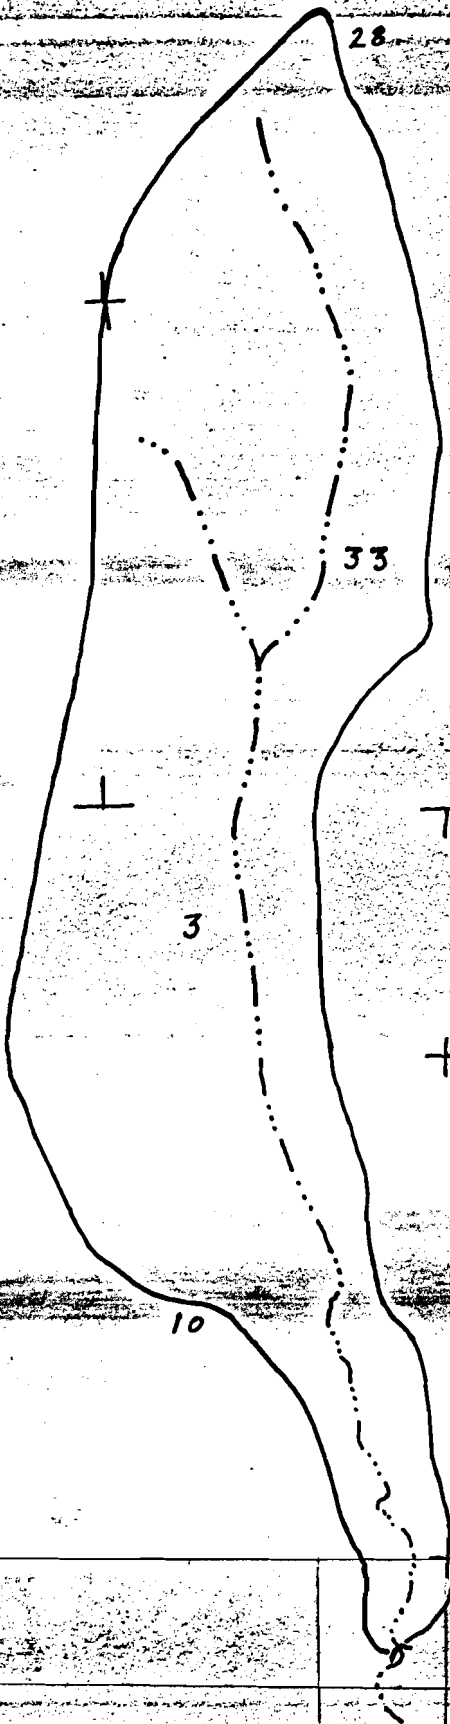

THE DAM IS 950 FT. SOUTH AND
500 FT. WEST OF THE NE COR.
SEC. 15 T.31S., R.27E., WILL. MER.
HARNEY COUNTY OREGON

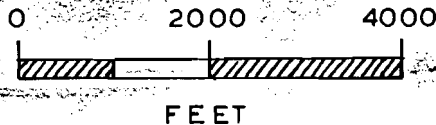

U. S. DEPARTMENT OF THE INTERIOR
BUREAU OF LAND MANAGEMENT

LITTLE DRAW RES.

DESIGNED _____
REVIEWED _____
APPROVED _____

DRAWN BY	SCALE AS SHOWN
DATE 10-8-81	SHEET 1 OF 1
DRAWING NO.	