

R 9253
63202

RECEIVED
SEP 23 1983
WATER RESOURCES DEPT.
SALEM, OREGON


UNITED STATES
DEPARTMENT OF THE INTERIOR
BUREAU OF LAND MANAGEMENT

Oregon State Water Filings

SECTION 17
NE 1/4 SW 1/4

TOWNSHIP 39S. RANGE 3E. W. M.

Application No. R-66703, 66704
Permit No. R 9253 48168

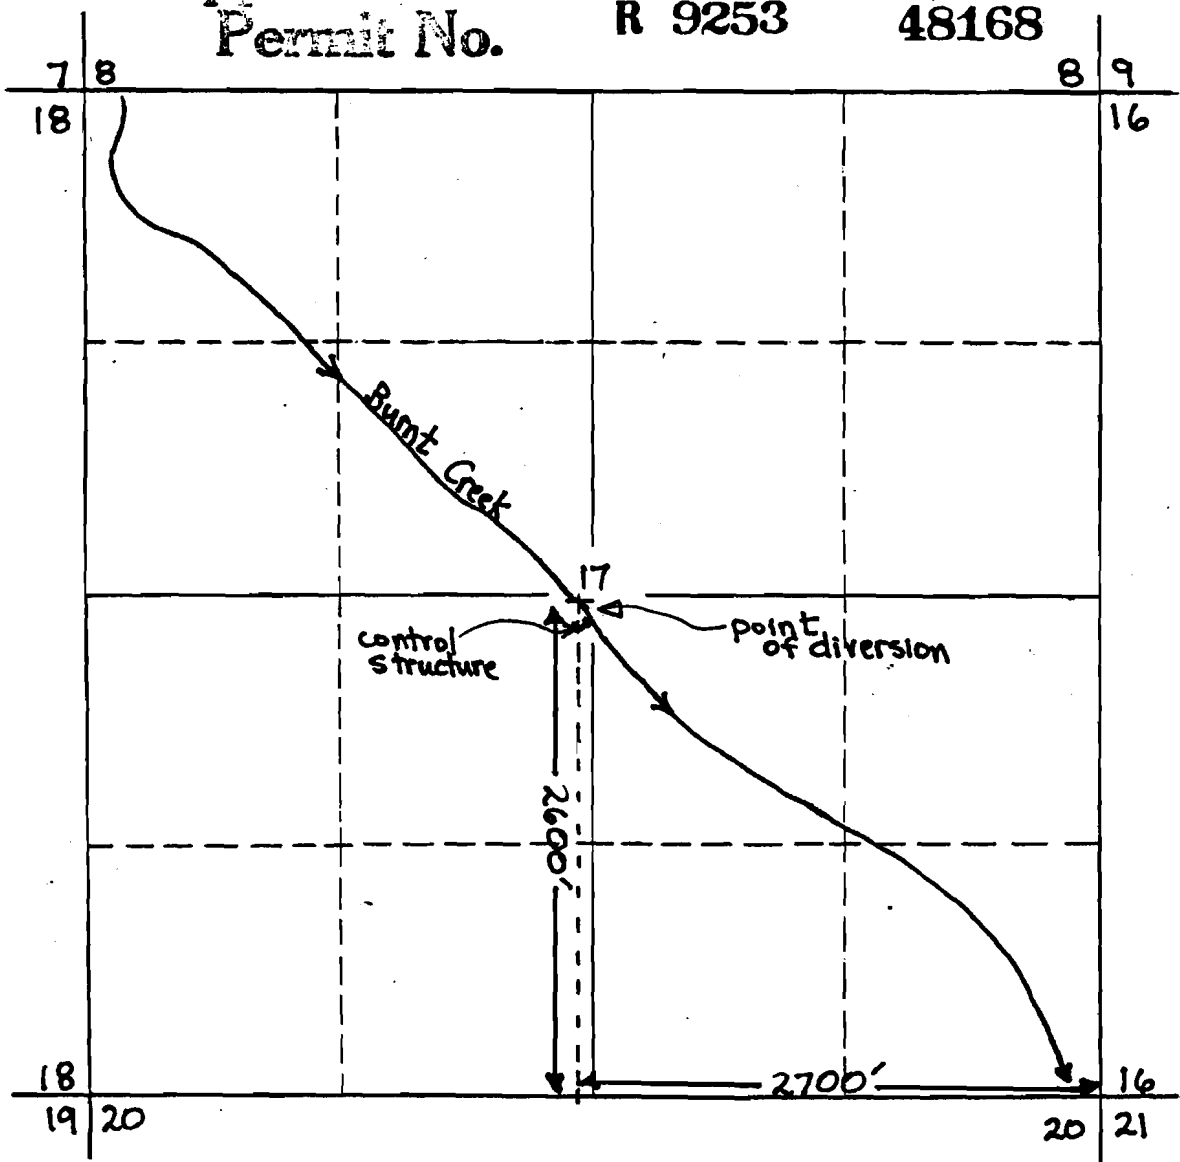

SCALE: 1" = 1000'

Enlargement
of Diversion
and Reservoir

