

UNITED STATES
DEPARTMENT OF THE INTERIOR
BUREAU OF LAND MANAGEMENT

RECEIVED


SEP 23 1983
WATER RESOURCES DEPT.
SALEM, OREGON

SECTION 13
NW 1/4 NE 1/4

Oregon State Water Filings

TOWNSHIP 39S., RANGE 5E., W. M.

Application No. R-66711
Permit No. R 9257

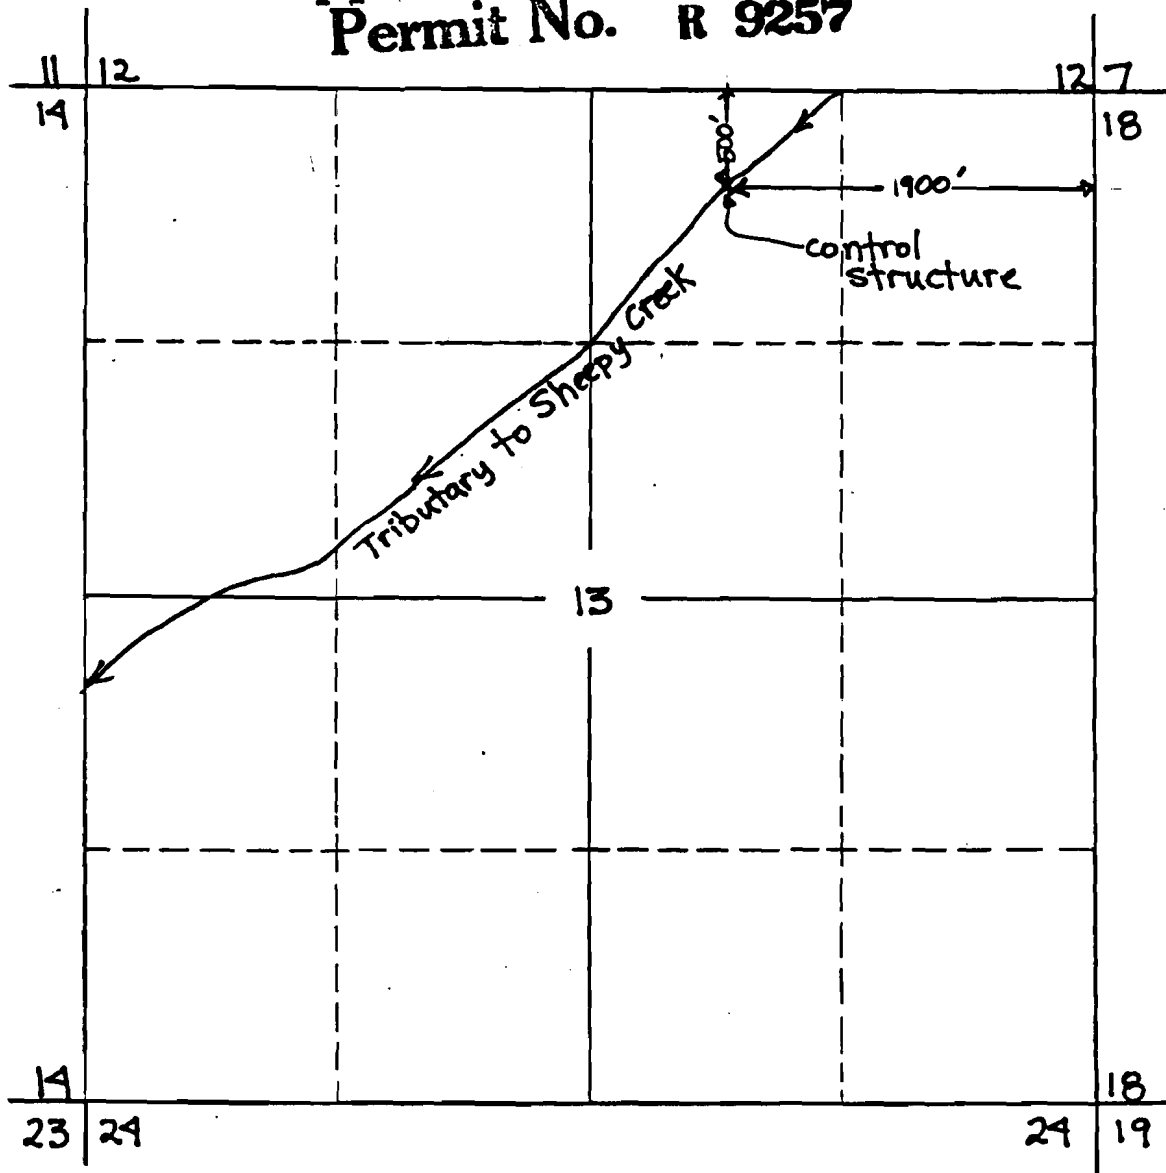

SCALE : 1" = 1000'

Jerry Crt. & Misc.