R-9258
63207

RECEIVED
SEP 23 1983
WATER RESOURCES DEPT.
SALEM, OREGON

UNITED STATES
DEPARTMENT OF THE INTERIOR
BUREAU OF LAND MANAGEMENT

Oregon State Water Filings

TOWNSHIP 39S., RANGE 5E., W. M.

SECTION 11
NW¼SW¼

Jenny Cr. & Misc.

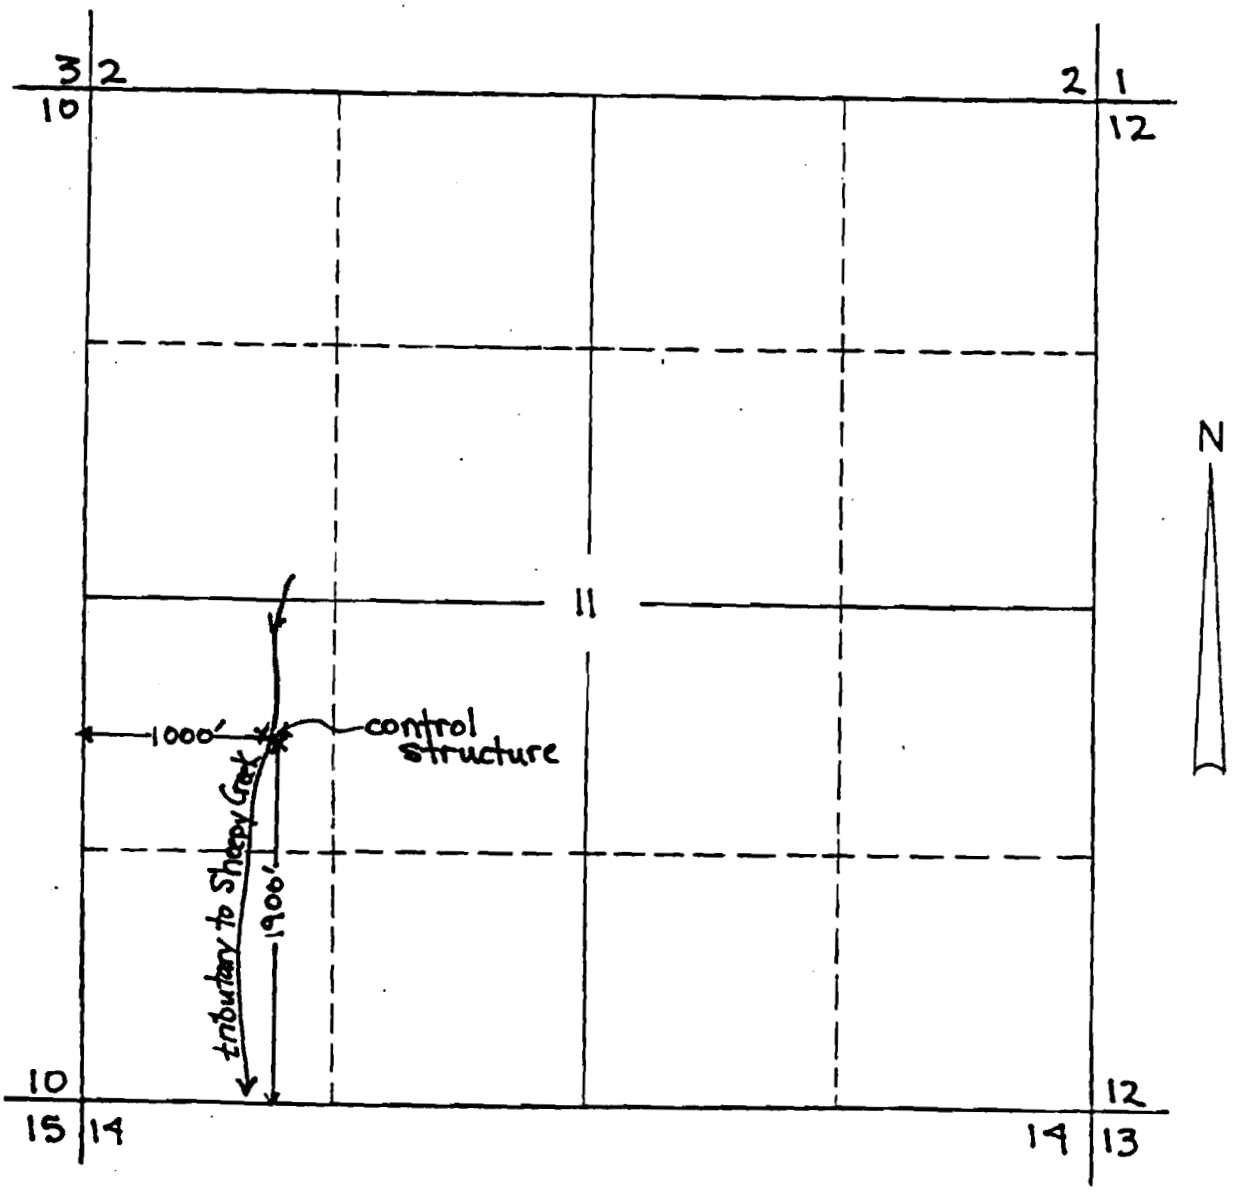

SCALE : 1" = 1000'

Application No. R-66712
Permit No. R 9258