

UNITED STATES
DEPARTMENT OF THE INTERIOR
BUREAU OF LAND MANAGEMENT

RECEIVED

SEP 23 1983

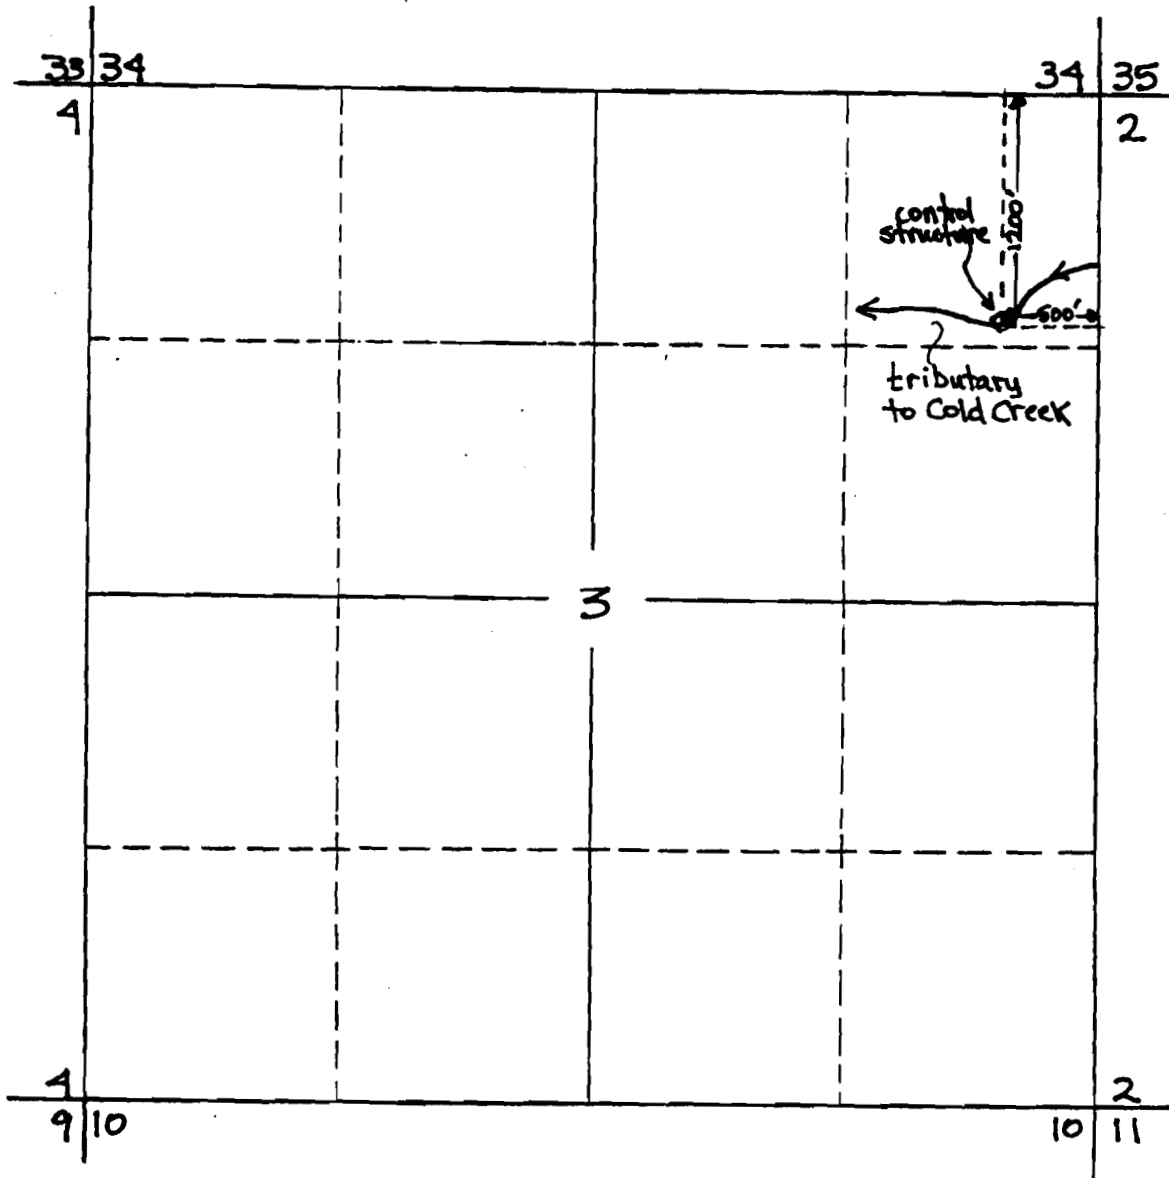
WATER RESOURCES DEPT.
SALEM, OREGON

SECTION

3

NE 1/4 NE 1/4

Oregon State Water Filings

TOWNSHIP 39S. RANGE 5E. W. M.

SCALE : 1" = 1000'

Application No. R-66713

Permit No.

R 9259