

R9261
63210

RECEIVED

SEP 23 1983
WATER RESOURCES DEPT.
SALEM, OREGON

UNITED STATES
DEPARTMENT OF THE INTERIOR
BUREAU OF LAND MANAGEMENT


Oregon State Water Filings

TOWNSHIP 39S., RANGE 4E., W. M.

SECTION

3

NW 1/4 NW 1/4

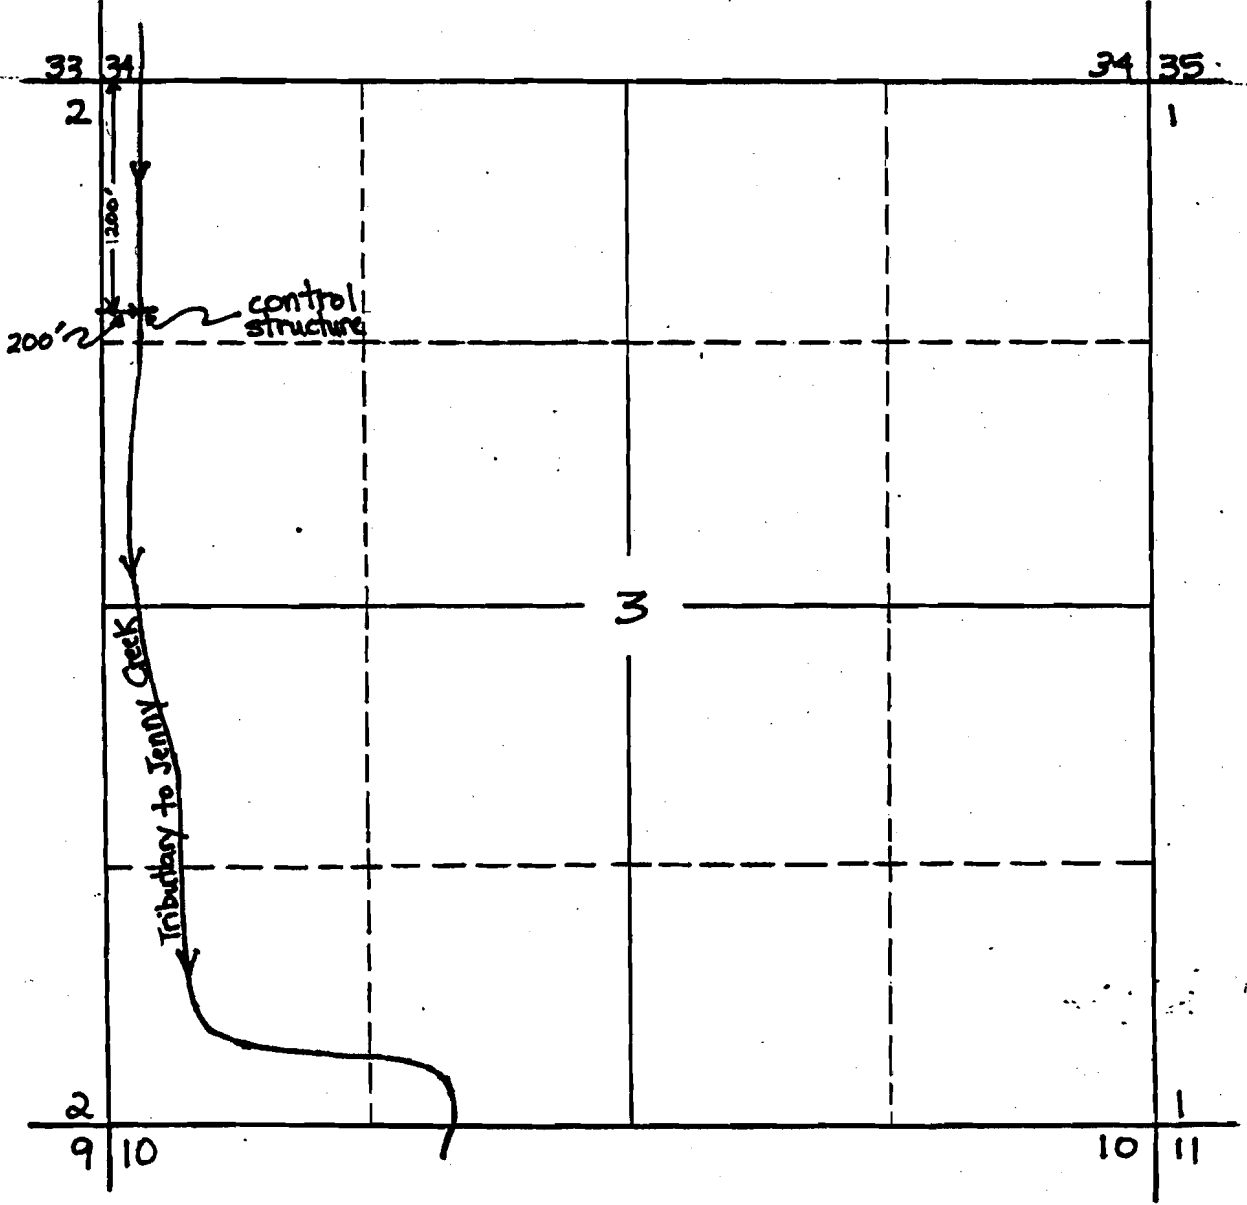

SCALE: 1" = 1000'

Application No. R-66715

Permit No. R 9261