


UNITED STATES
DEPARTMENT OF THE INTERIOR
BUREAU OF LAND MANAGEMENT

RECEIVED
SEP 28 1983
WATER RESOURCES DEPT.
SALEM, OREGON

SECTION

Oregon State Water Filings

TOWNSHIP 38S., RANGE 5E., W. M.

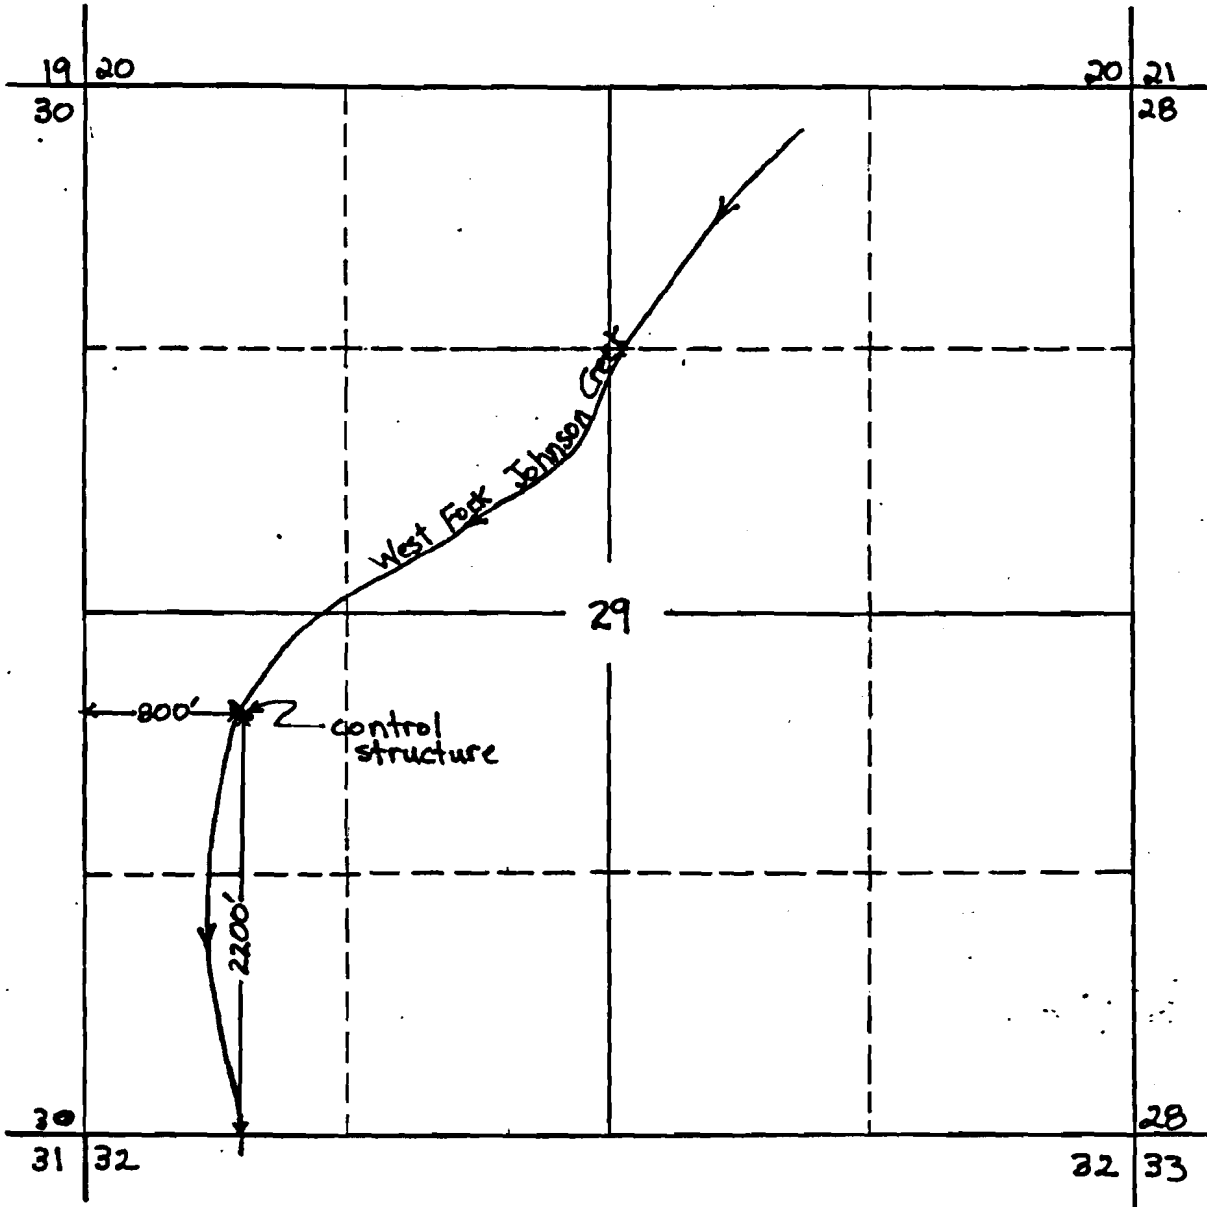

SCALE : 1" = 1000'

Application No. R-66718
Permit No. R 9264