

UNITED STATES
DEPARTMENT OF THE INTERIOR
BUREAU OF LAND MANAGEMENT

RECEIVED

JUL 31 1997

SECTION

9



WATER RESOURCES DEPT.
SALEM, OREGON

NWNW

TOWNSHIP 17 S., RANGE 39 E., W. M.

North

ROCK RESERVOIR

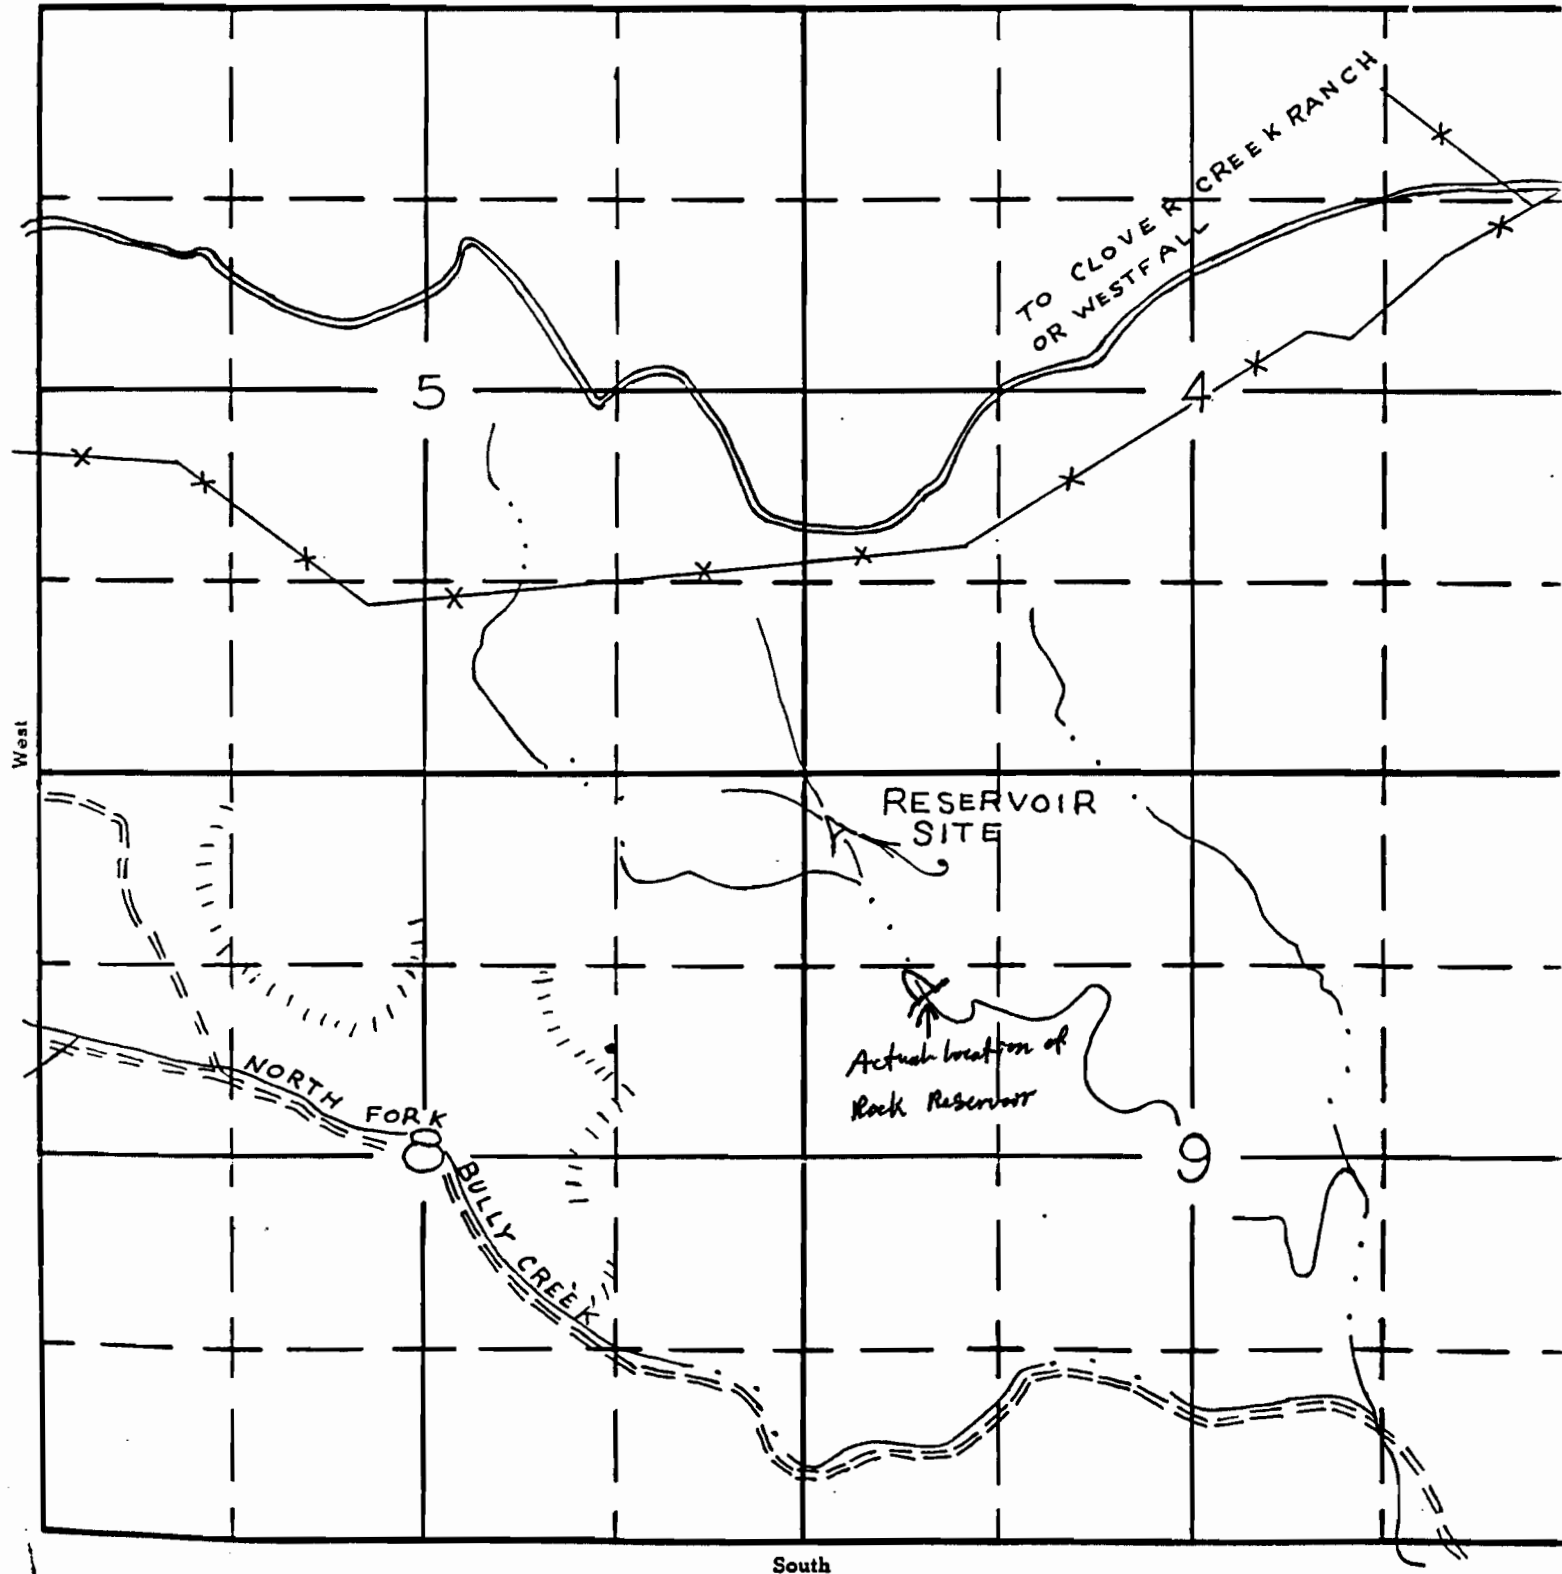

South

APPLICATION No. R-6785
PERMIT No. R1066