

UNITED STATES
DEPARTMENT OF THE INTERIOR
BUREAU OF LAND MANAGEMENT


SECTION 23
S.W. N.E.

Oregon State Water Filings

TOWNSHIP 17^S, RANGE 42^E, W. M.

North BANNOCK CORRALS

Application No. R 63568
Permit No. **R 9301**

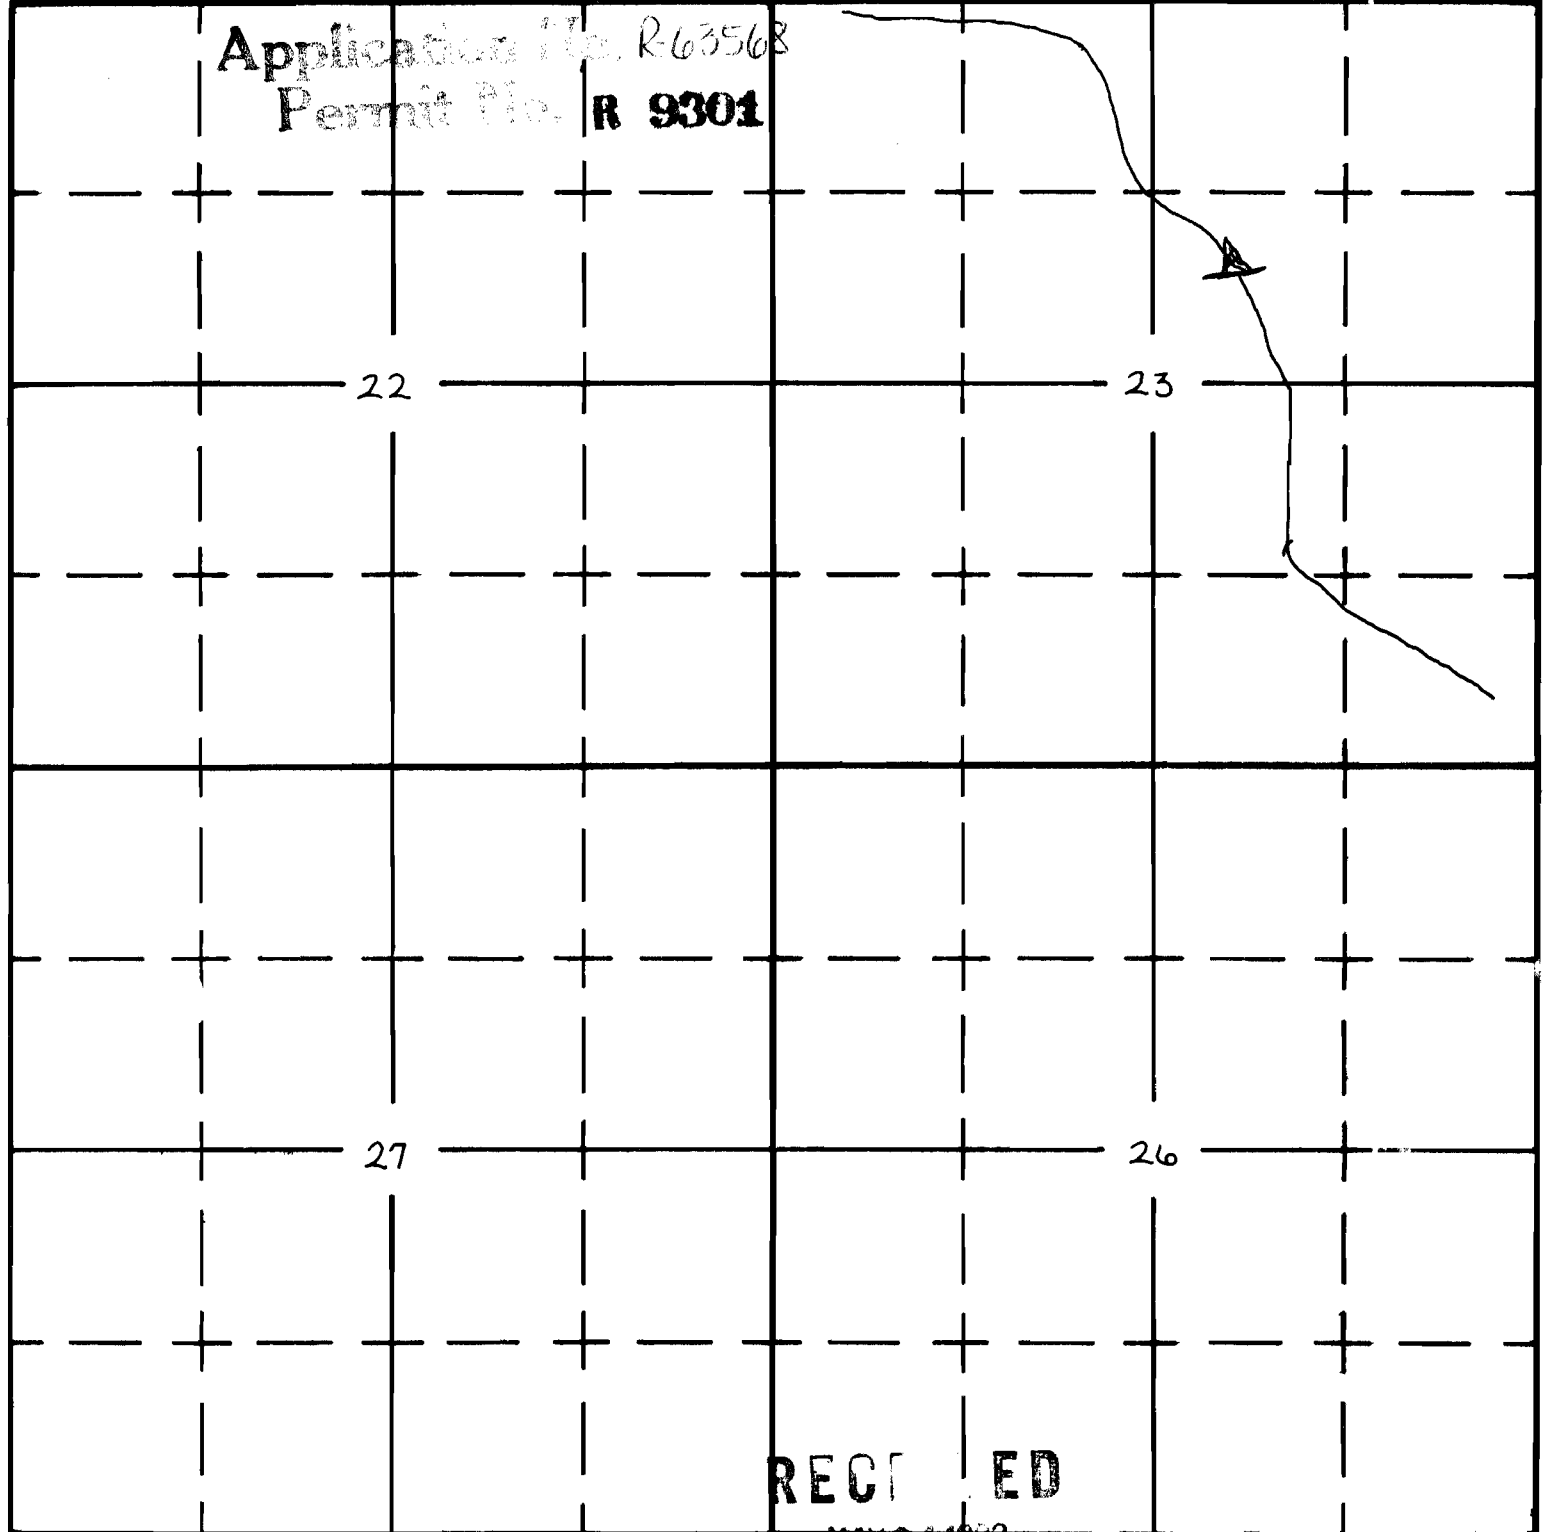

RECEIVED

MAY 24 1962

WATER RESOURCES DEPT
SALEM, OREGON

APPLICATION No.
PERMIT No.