

-187
1961

UNITED STATES
DEPARTMENT OF THE INTERIOR
BUREAU OF LAND MANAGEMENT

RECEIVED
MAR 18 1961

SECTION


Oregon State Water Filings

TOWNSHIP 17^S, RANGE 43^E, W. M.

7
N.E. SW

North

MORRISON DIVERSION

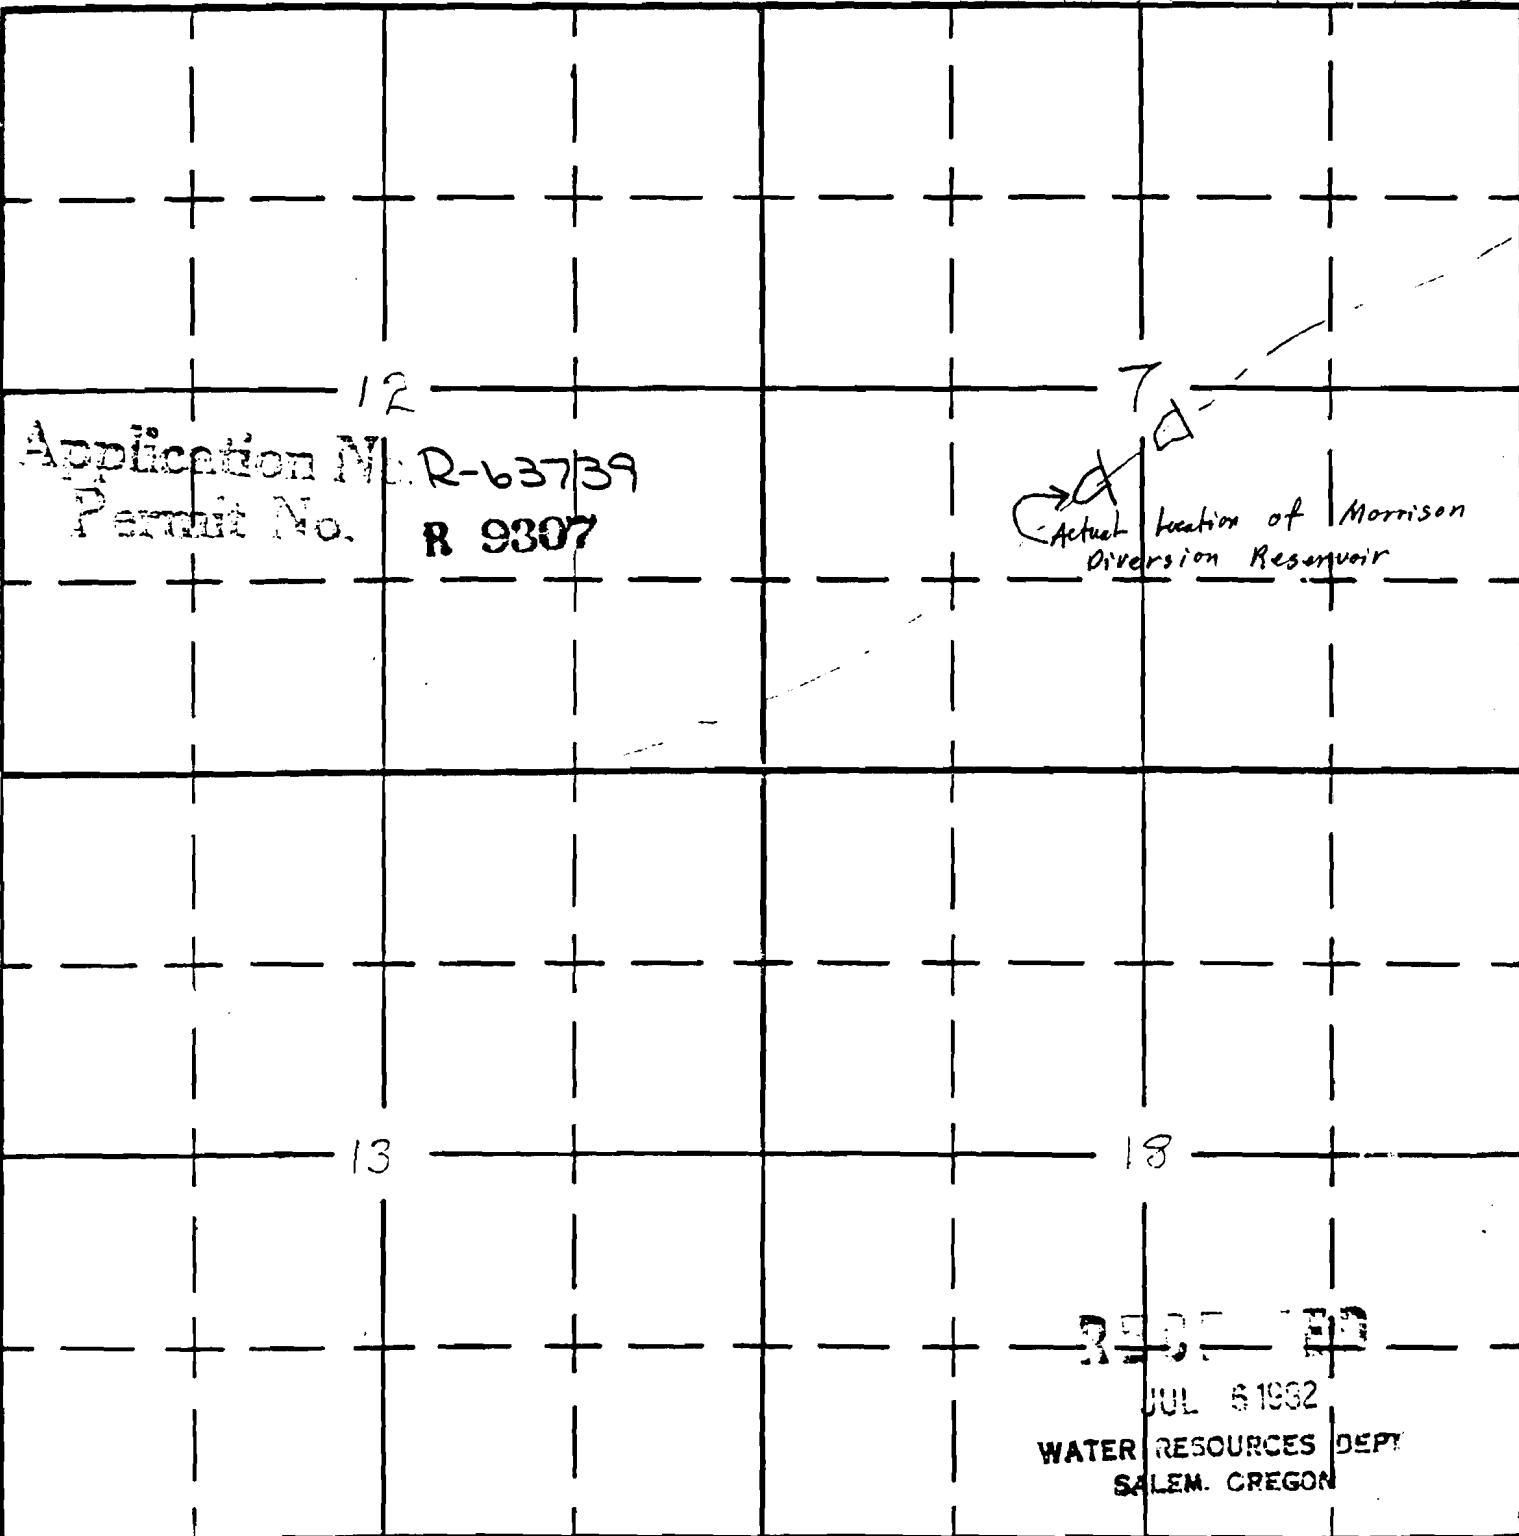

South

APPLICATION No.

DEPARTMENT OF THE INTERIOR