

R9477
03227

Form OR-010-7300-2
4/83

UNITED STATES
DEPARTMENT OF THE INTERIOR
BUREAU OF LAND MANAGEMENT


Section 1
SE NW

Township 39S
Range 23E

Appl. No. R67613
Permit No. R 9477

Will. Mer.

Cabin Reservoir #1113

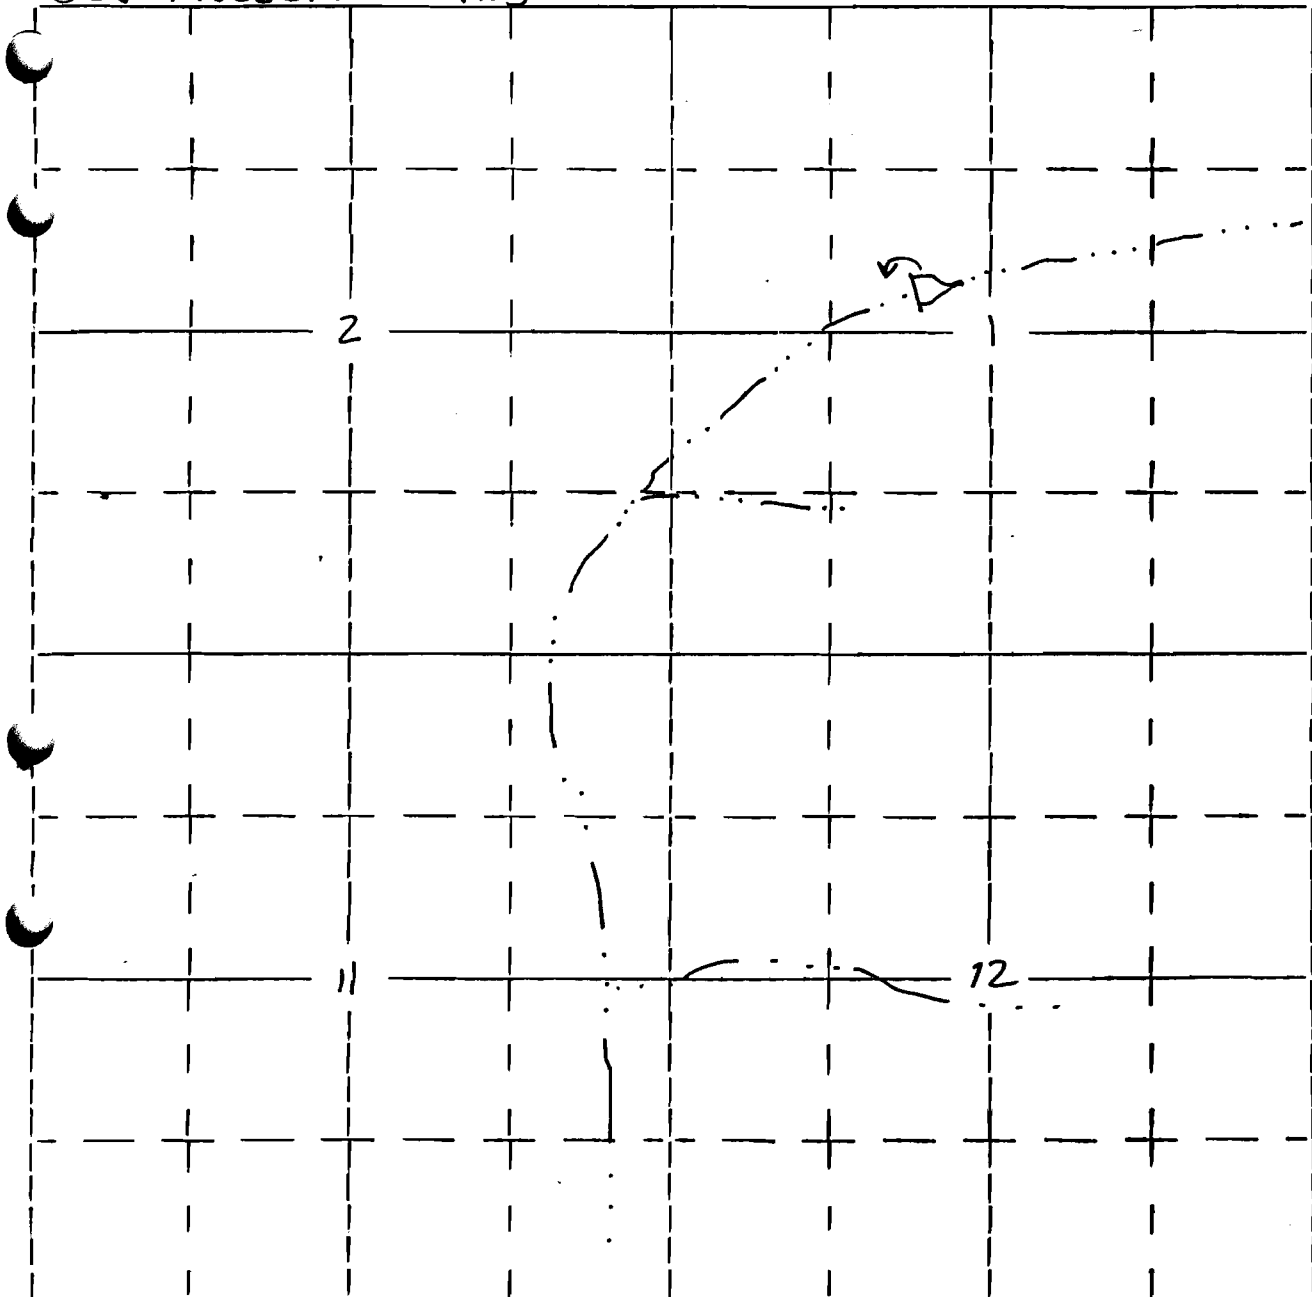

2000'S 2500'E of the NW corner of section 1