

R-9820  
63230

Form OR-010-7300-2  
4/83

UNITED STATES  
DEPARTMENT OF THE INTERIOR  
BUREAU OF LAND MANAGEMENT

Section 7, 8, 17, 18

Township 41S

Appl. No. R-657608

Range 15E


Permit No. R 9820

Will. Mer.

**RECEIVED**

AUG 25 1983  
WATER RESOURCES DEPT.  
SALEM, OREGON

*Rock Out. 8' Wide.*

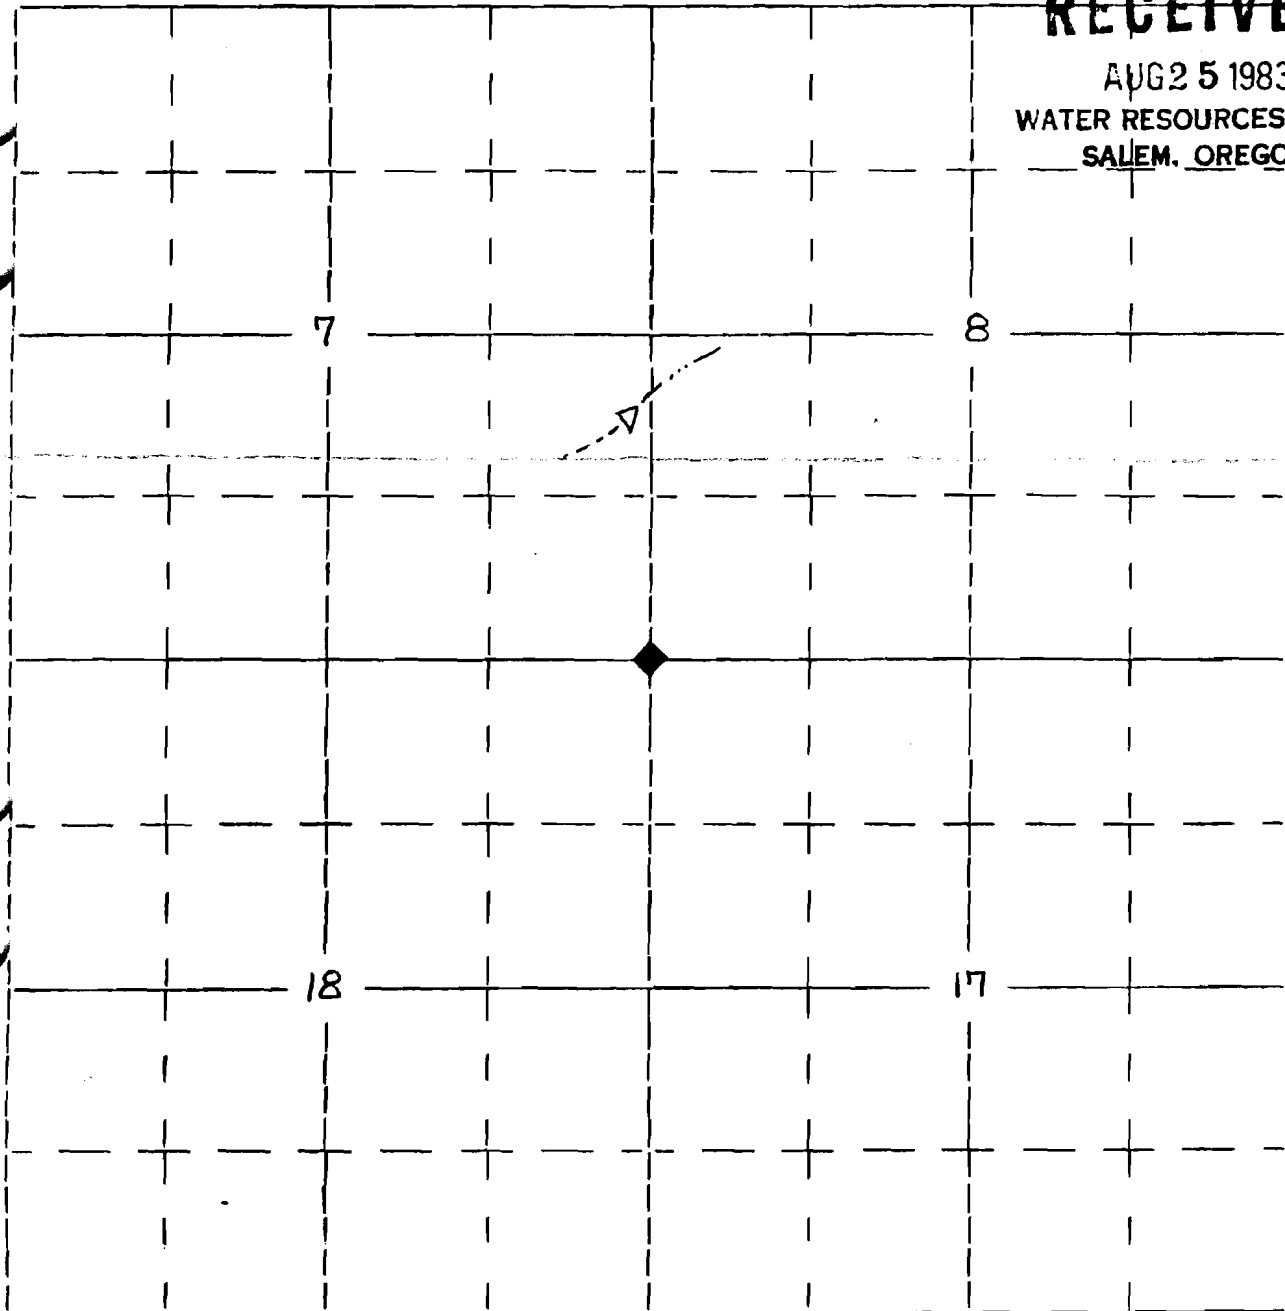

RESUR. IS 2046' NORTH AND 165' WEST OF CORNER COMMON  
TO SECTIONS 7, 18, 17, 18