

SECTION

27

NW SE


TOWNSHIP 40S, RANGE 37E, W. M.

11-1337

SAGEHEN SPRING

CHECK

North

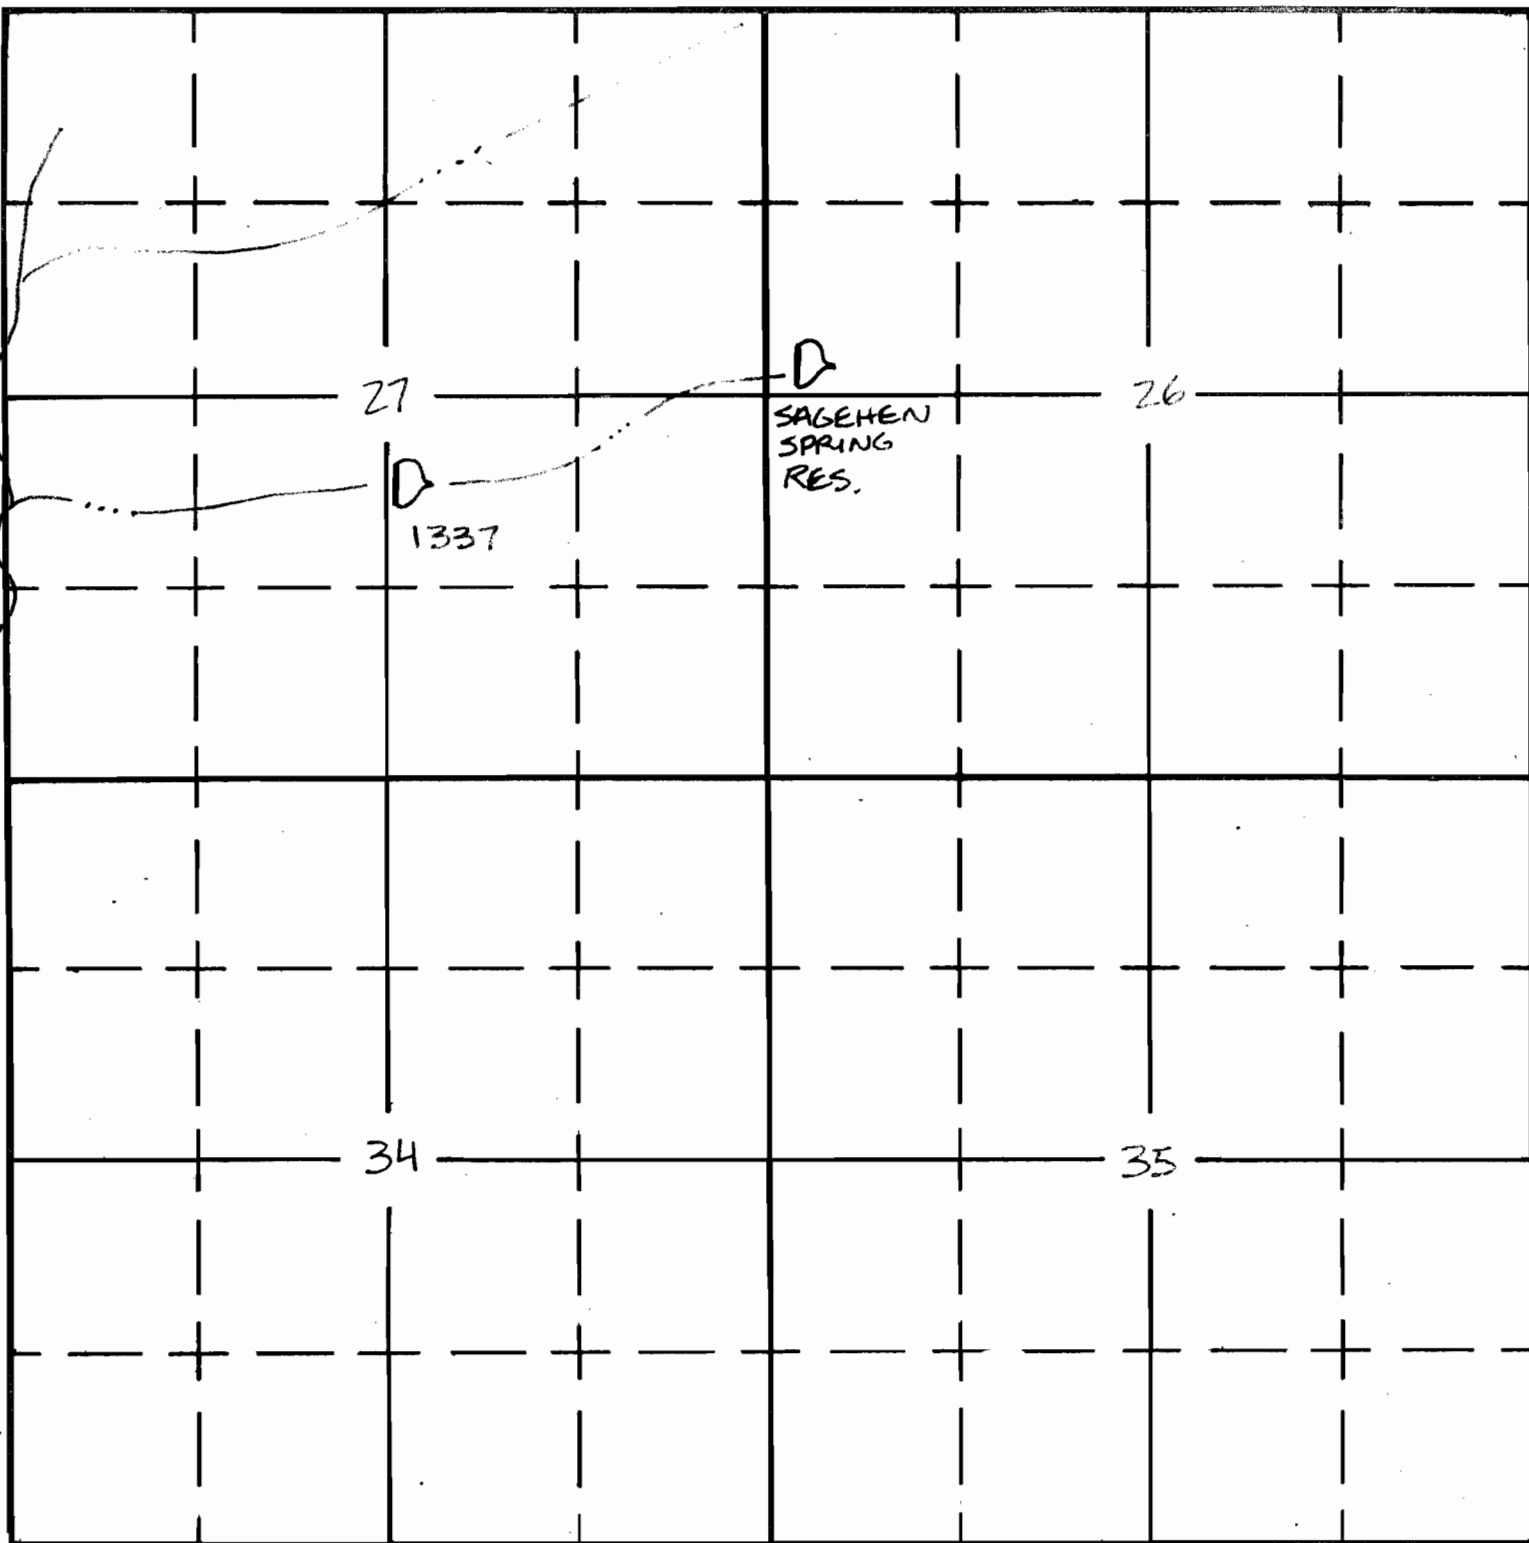

South

Application No. R66424
Permit No. R10203

SEP 14 1983
SALEM, OREGON