


SECTION

30
NE SE

11-4663
TOWER SPR. RES. #4

TOWNSHIP 40S, RANGE 38E, W. M.

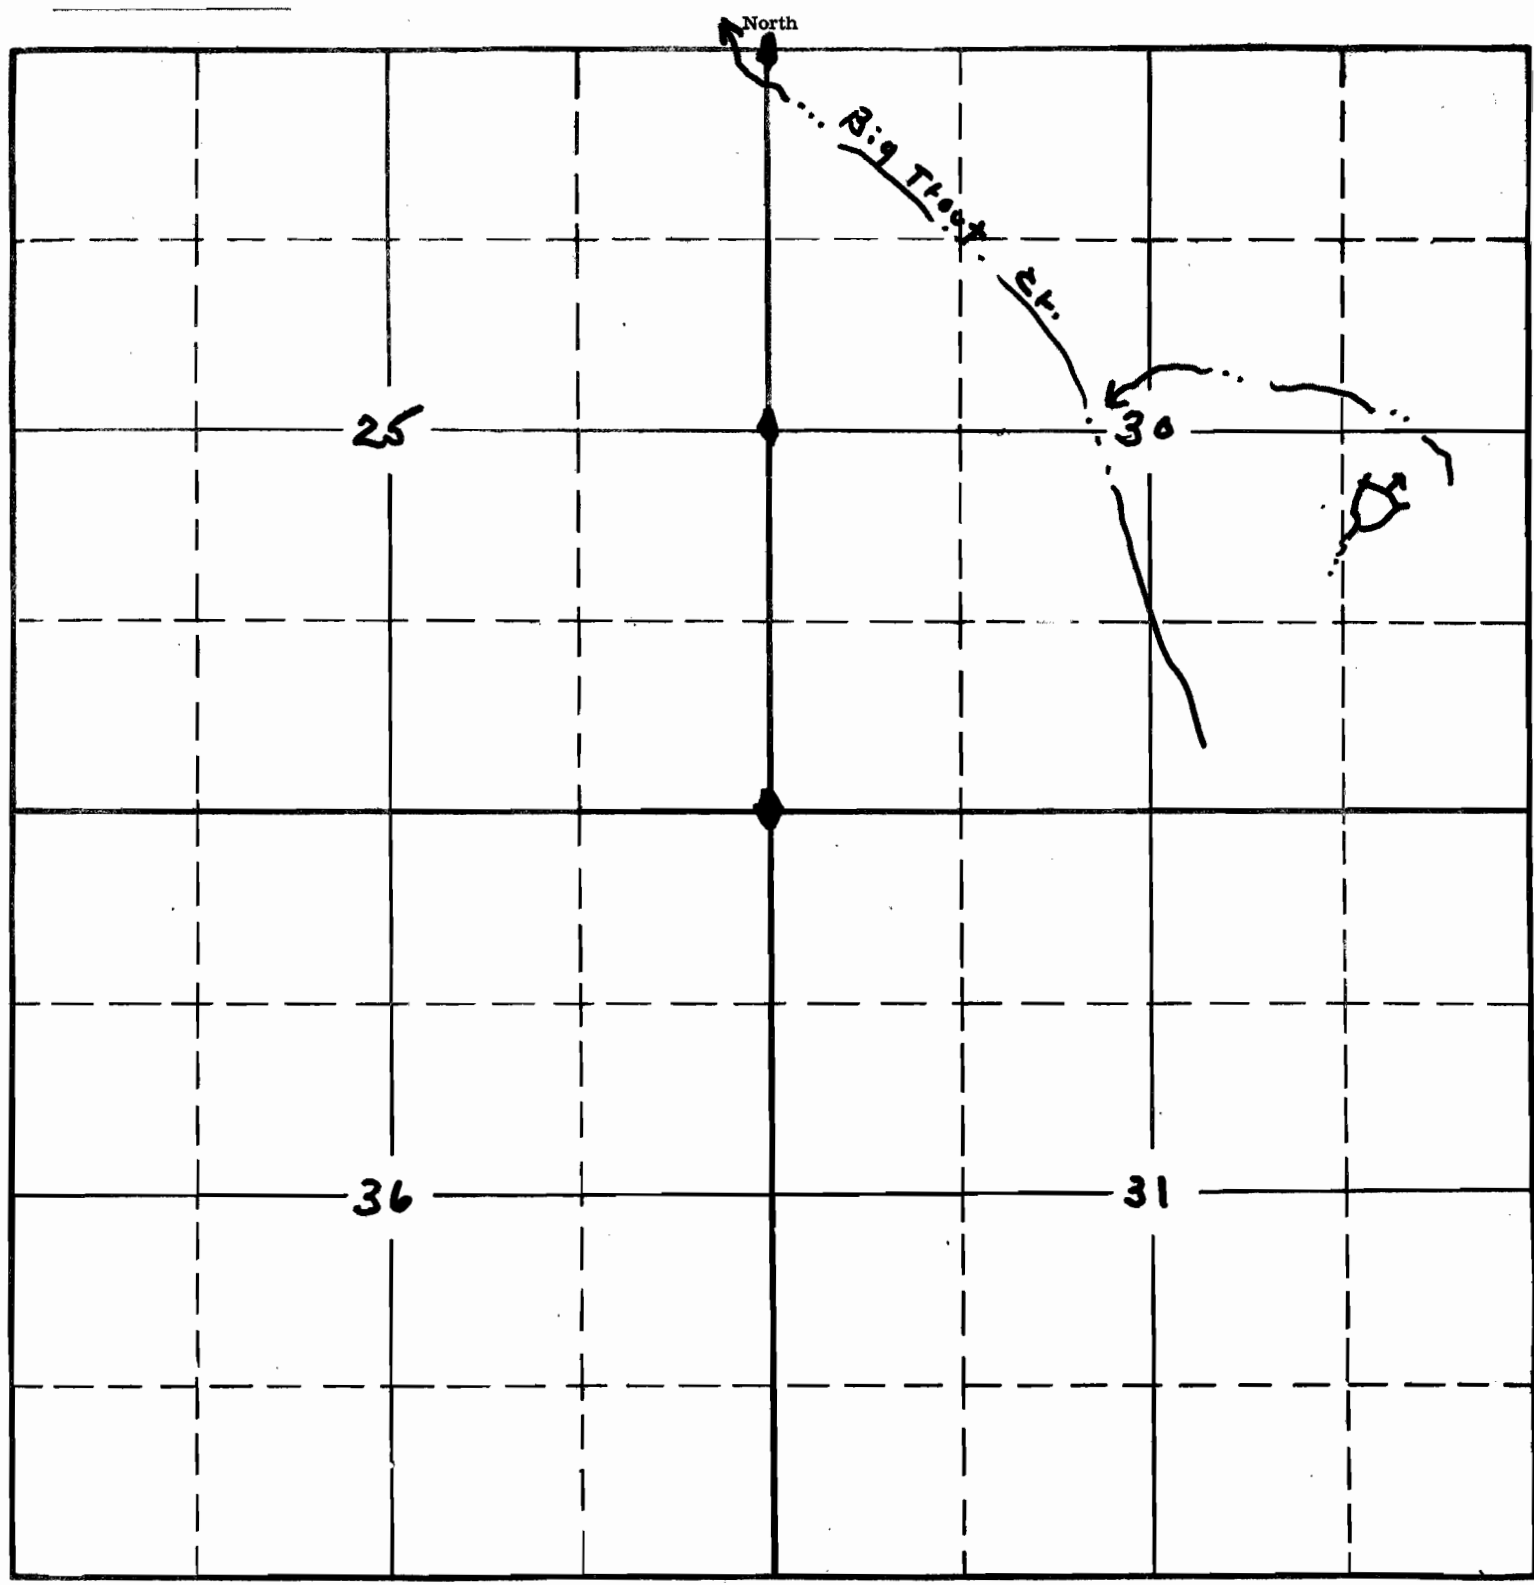

Application No. **R66435**
Permit No. **R10212**

APPLICATION No.
PERMIT No.