

SECTION

9


NE NE

TOWNSHIP 39S, RANGE 37E, W. M.

North

West

East

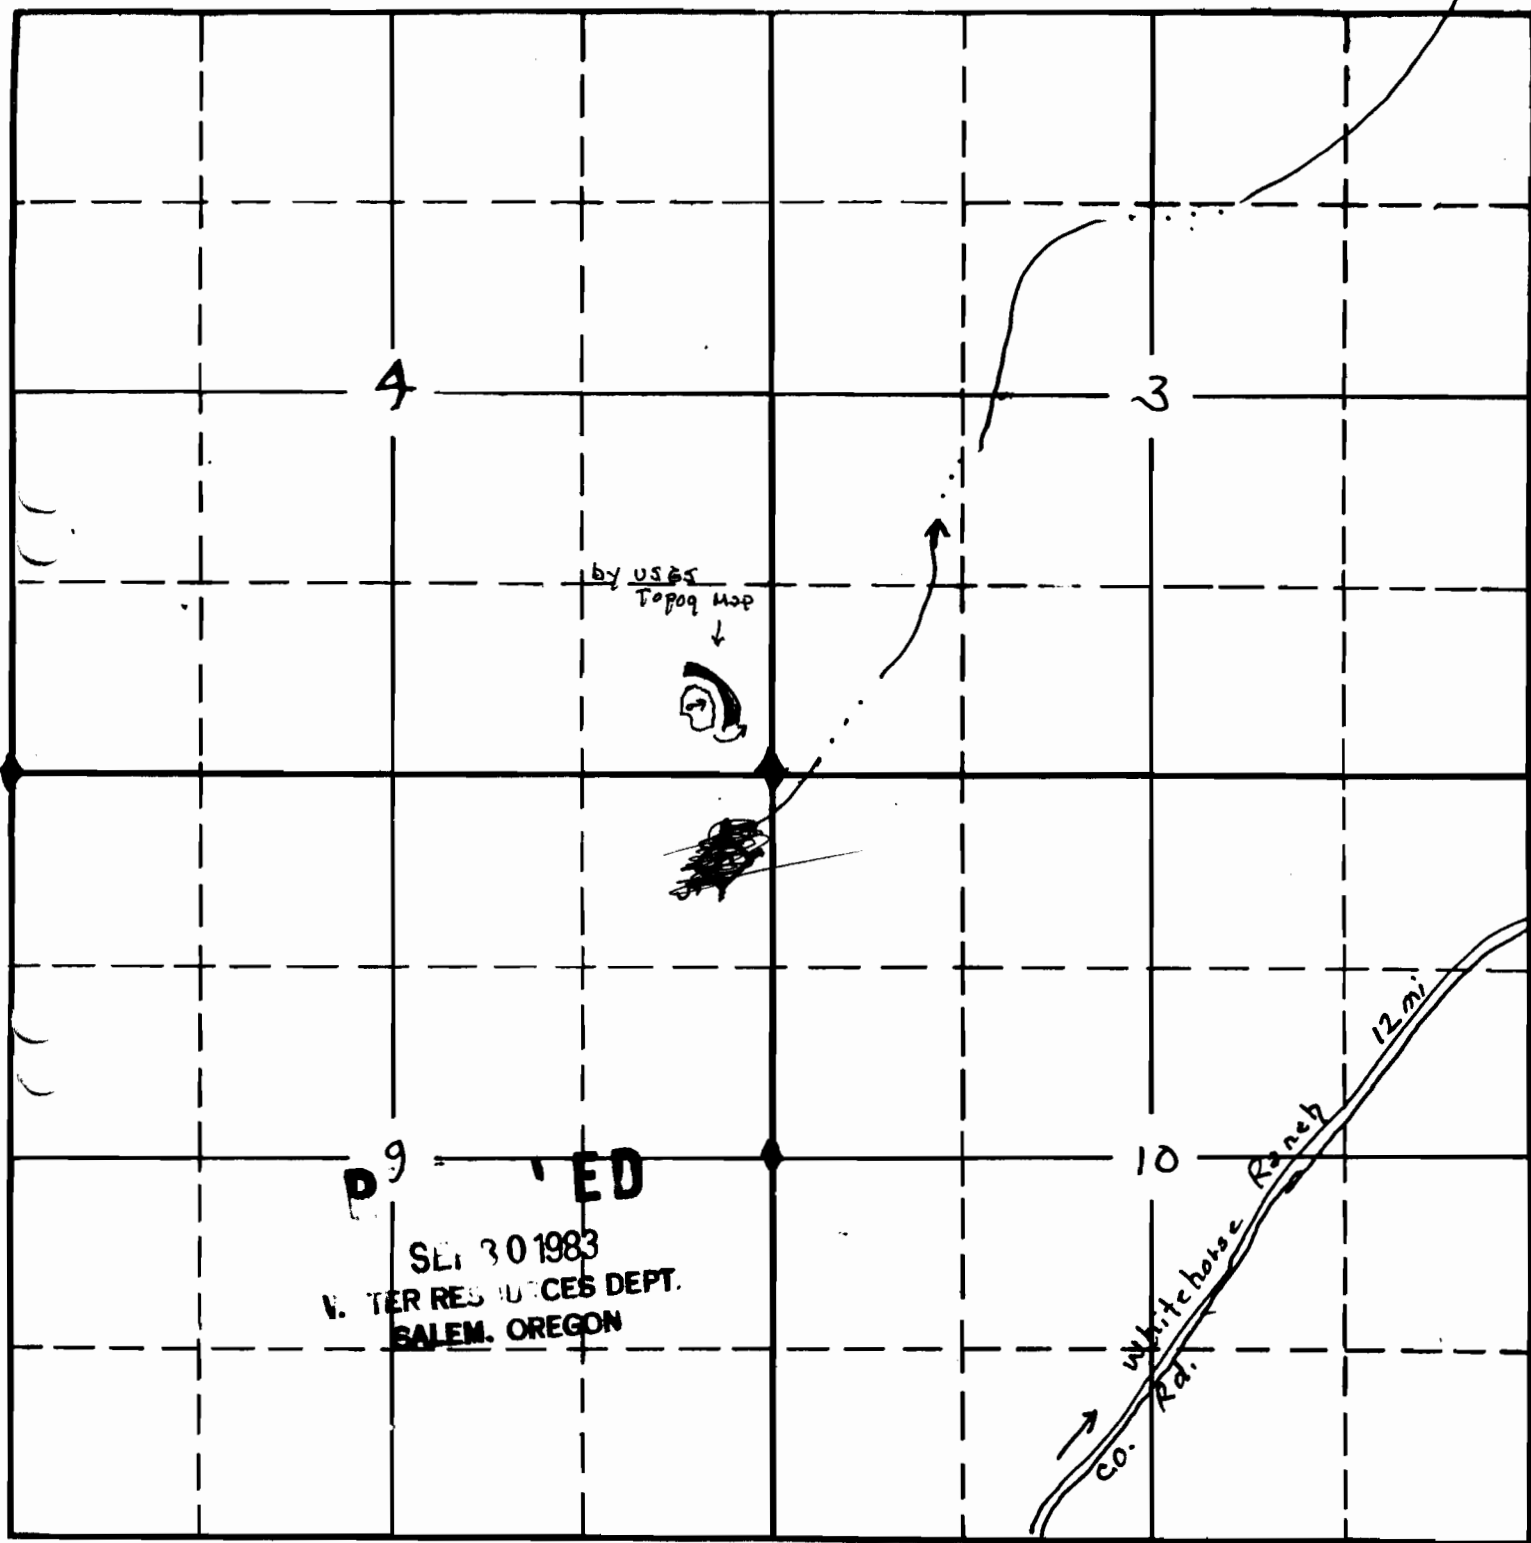

SEP 30 1983
WATER RESOURCES DEPT.
SALEM, OREGON

South

APPLICATION No.

PERMIT No.

R10366

R-67040