

SECTION


7

NE NW

11-4290

S. Buckbrush Waterhole

TOWNSHIP ^{37S}~~34S~~, RANGE ^{34E}~~37E~~, W. M.

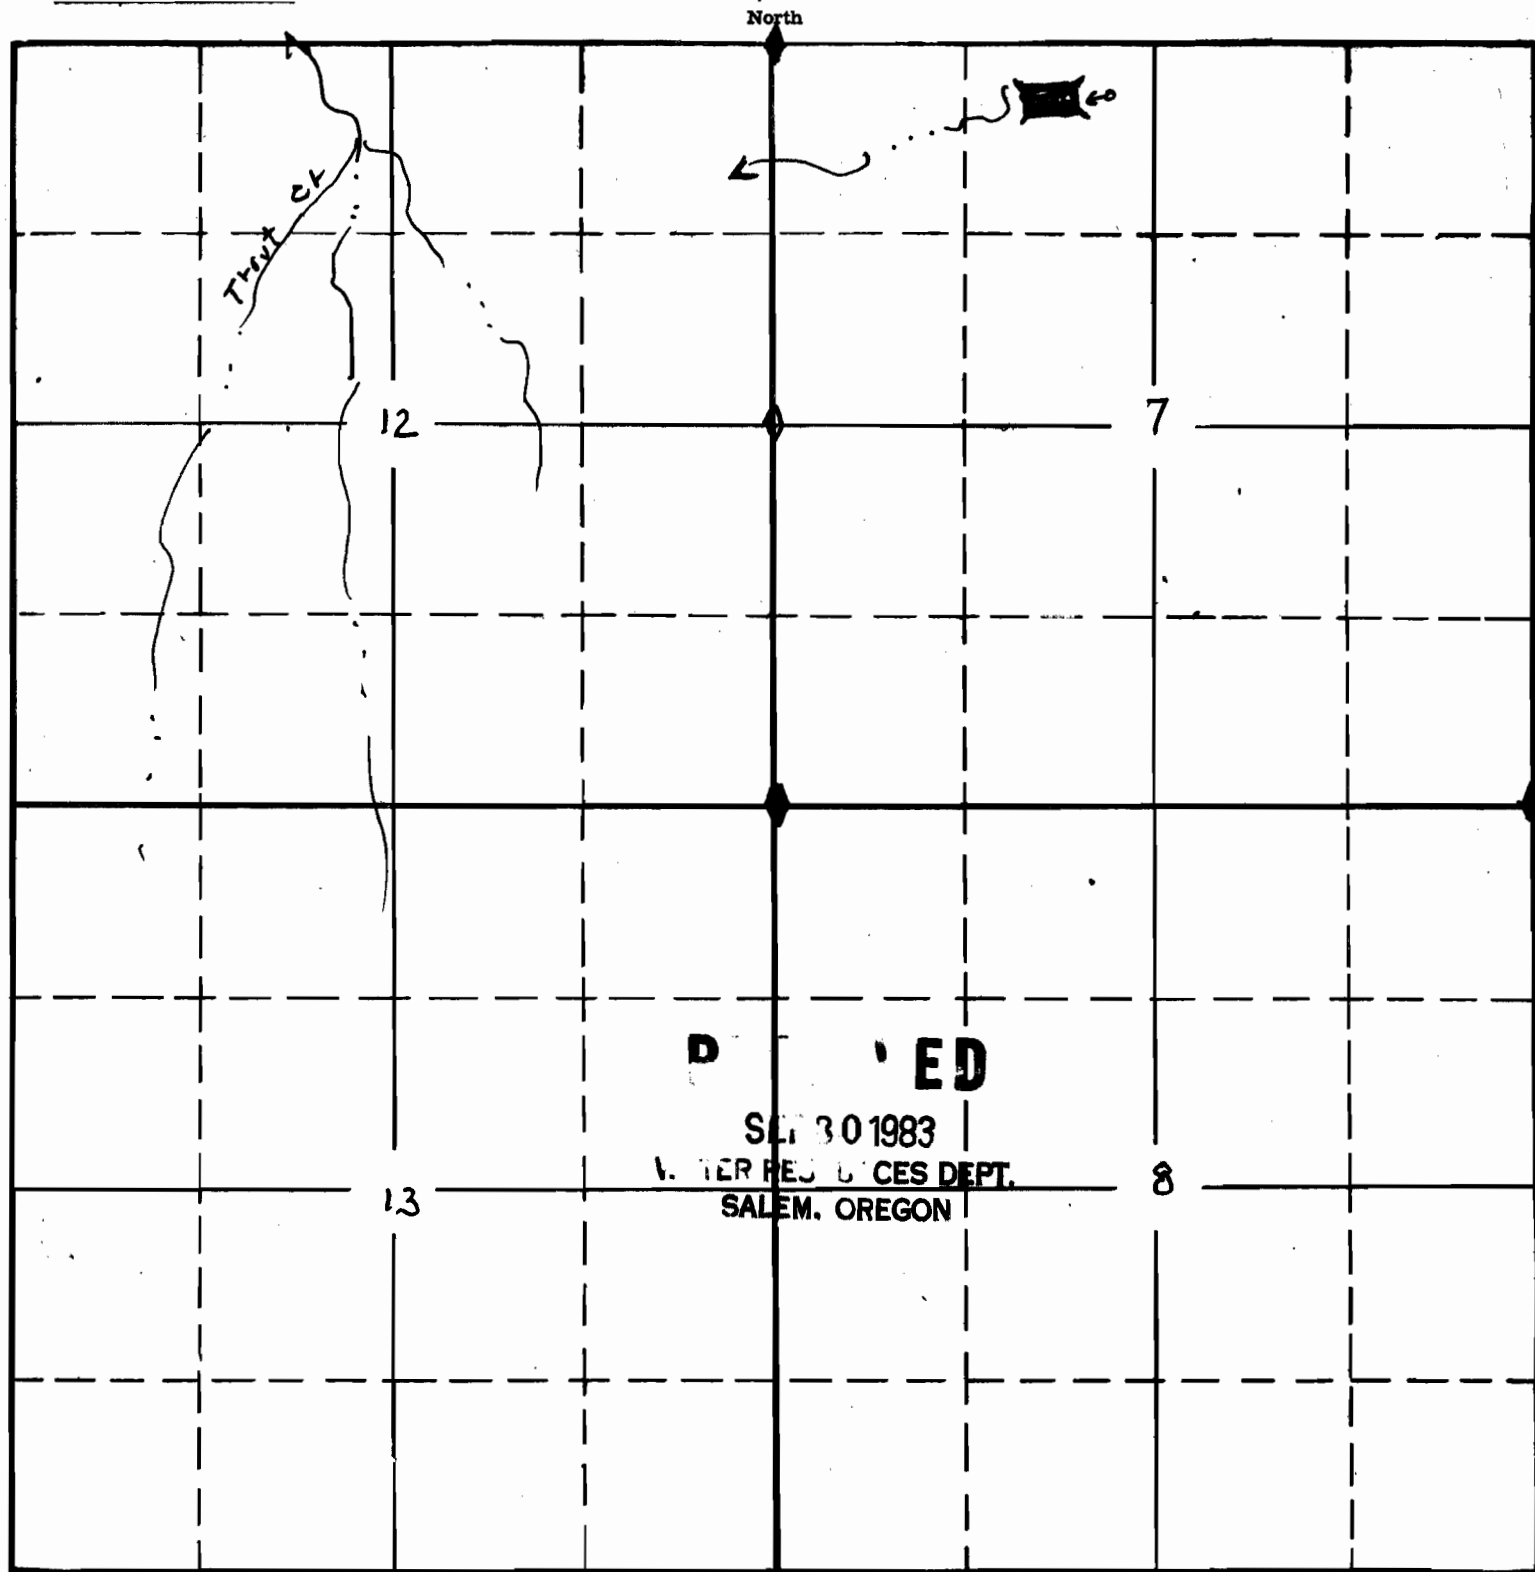

South

RECEIVED

JAN 16 1985

WATER RESOURCES DEPT
SALEM, OREGON

R-67045

APPLICATION No.

PERMIT No.

R10720