
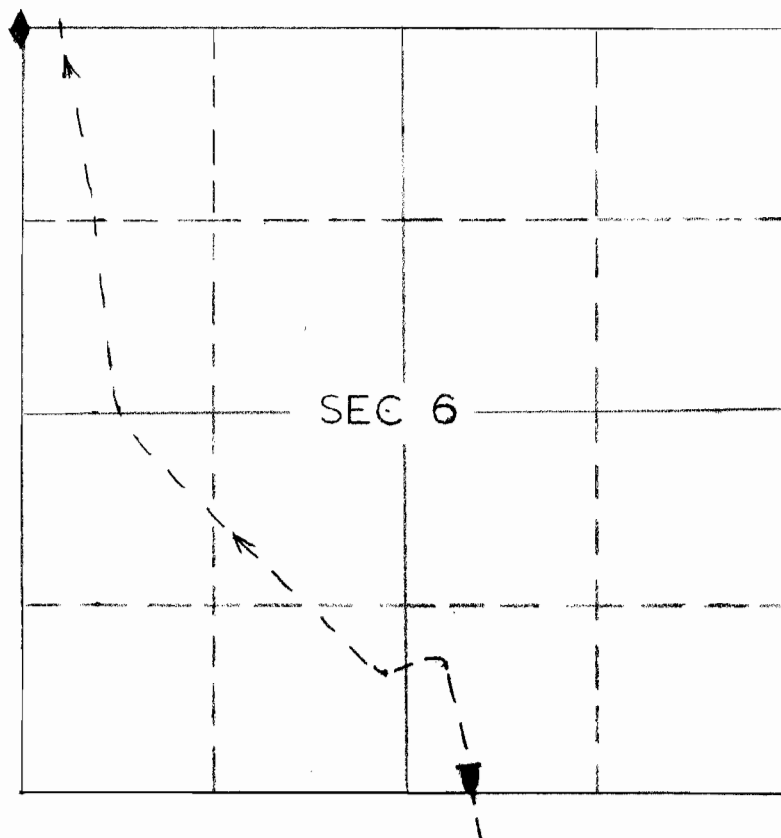


 

RESERVOIR IS 4680' SOUTH AND 2730'
EAST OF THE NORTHWEST CORNER OF
SEC. 6 T. 18 S. R. 24 E.

Application No. R-68946
Permit No. R10823

U. S. DEPARTMENT OF THE INTERIOR
BUREAU OF LAND MANAGEMENT

ALKALI RESERVOIR

DESIGNED _____

RECOMM. _____

DRAWN LDT

RECOMM. _____

CHIEF, DIV. OF ENG.

CHECKED _____

APPROVED _____

SCALE 4" = 1 MILE

DATE _____

SHEET _____ OF _____

DRAWING NO. _____