


PW-184

# T.2N.,R.13E.,W.M.

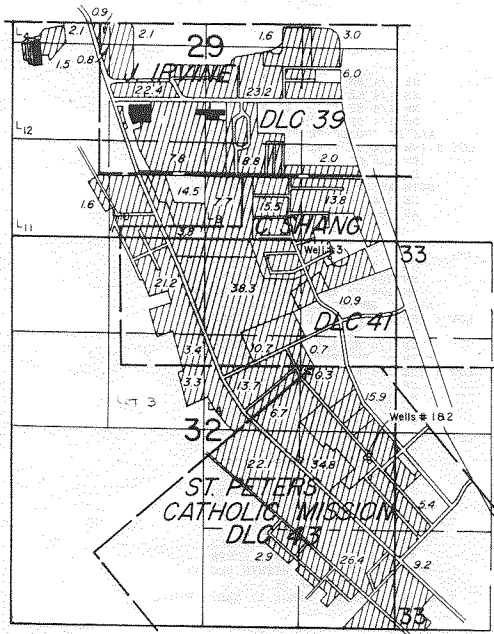

WELL 1- 400'S. & 350' W., WELL 2- 350' & 400' W.,  
 WELL 3- 2360' N & 920' W,  
 ALL FROM THE E. 1/4 COR., SEC. 32.

## FINAL PROOF SURVEY UNDER

Application No. U-203 Permit No. U-184  
 IN NAME OF

CHENOWITH IRRIGATION COOPERATIVE, INC.

Surveyed JULY 25, 1979, by *J. Braun*

Revised Plat 184

41065-572-68