


# T. 40S., R. 19E., W.M.

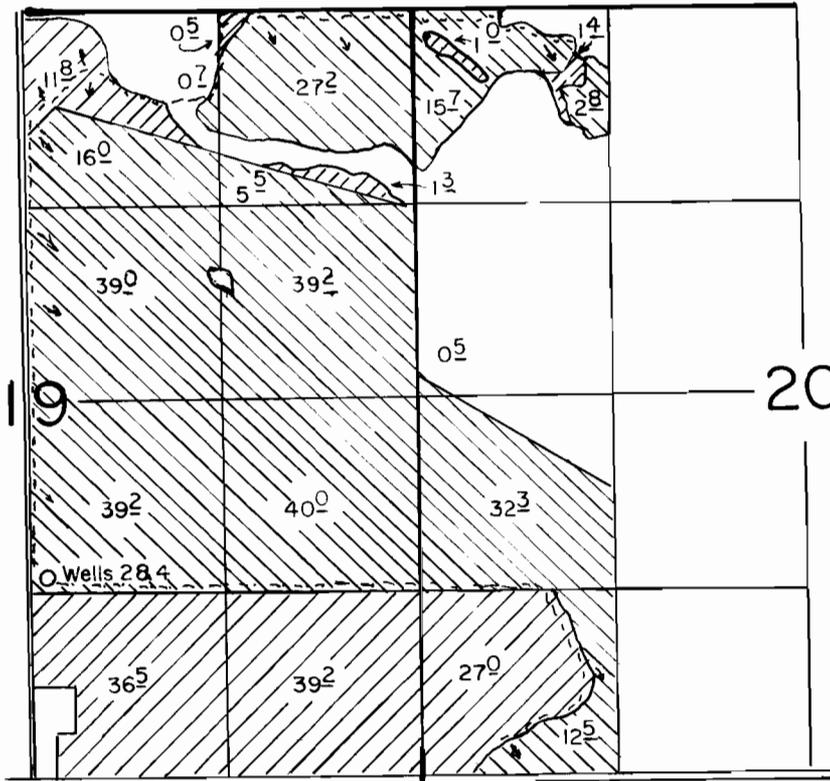

Well 2 Loc 108' N & 105.3 E., Well 4 Loc. 94' N. & 107' E., Both From  
 SW Corner NW1/4 SE1/4 Section 19

SCALE: 1" = 1320'

Primary Wells 2 & 4  
 Supplemental Well No. 4

## FINAL PROOF SURVEY UNDER

Application No. G-82.07... Permit No. G-86.48....  
 IN NAME OF

..... CLYDE W. FENIMORE .....

Surveyed OCT. 16... 1987... by B. S. JAMES .....