



T39S., R.20E., W.M.

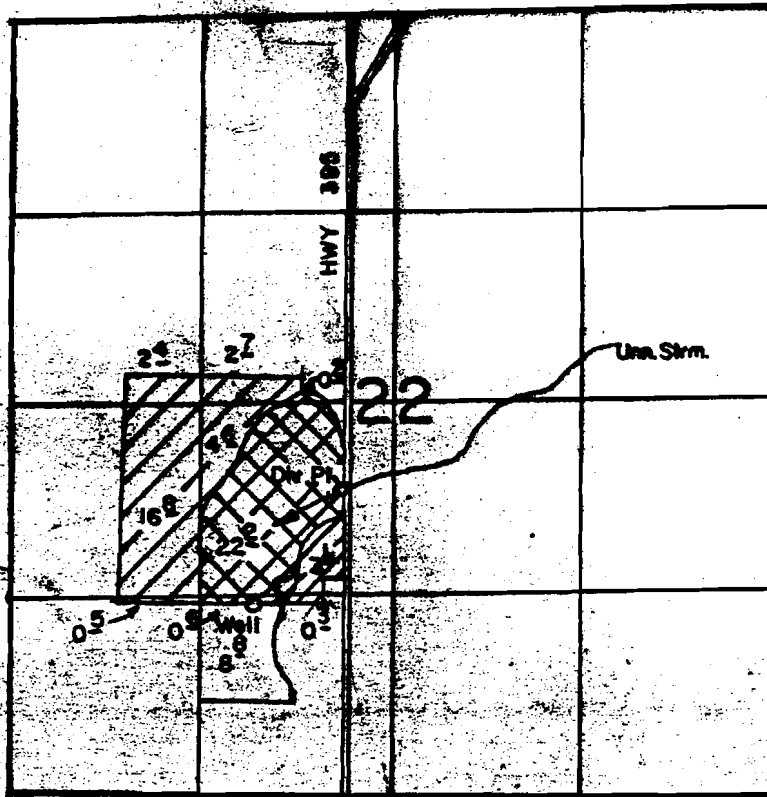

Well Located 1300' N & 950' W From S1/4 Corner Sec 22
 Dam Pt. Located 2100' N & 350' W From S1/4 Corner Sec 22

SCALE 1" = 1320'

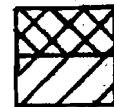

Permit 44573
 Permit 6-8706

FINAL PROOF SURVEY UNDER

58680 44573

Application No. G-9248.. Permit No. G-8706....
 IN NAME OF

..... EDWIN L. DEPAOLI

Surveyed OCT 19, 1987, by V.L. CHURCH