


# T.6S.,R.IW.,W.M.

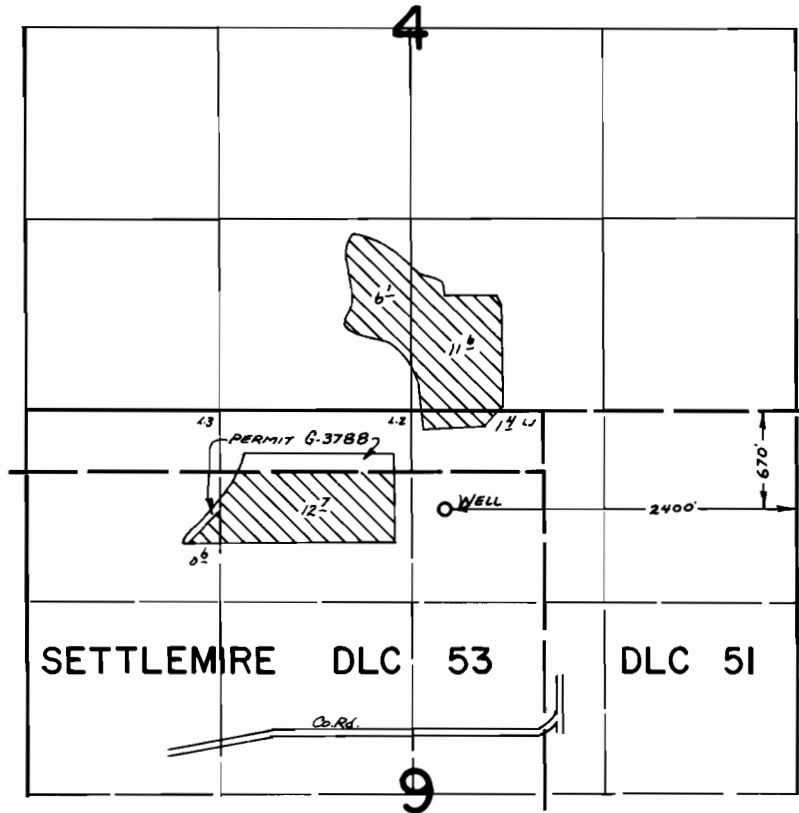

## FINAL PROOF SURVEY UNDER

Transfer No. 4298  
Application No. G-9405 Permit No. G-8751.....  
IN NAME OF

RUEF'S FUR RANCH

Surveyed Sept. 8, 1981, by S. C. BROWN