



G-9721
63273

T.39S., R.19E., W.M.

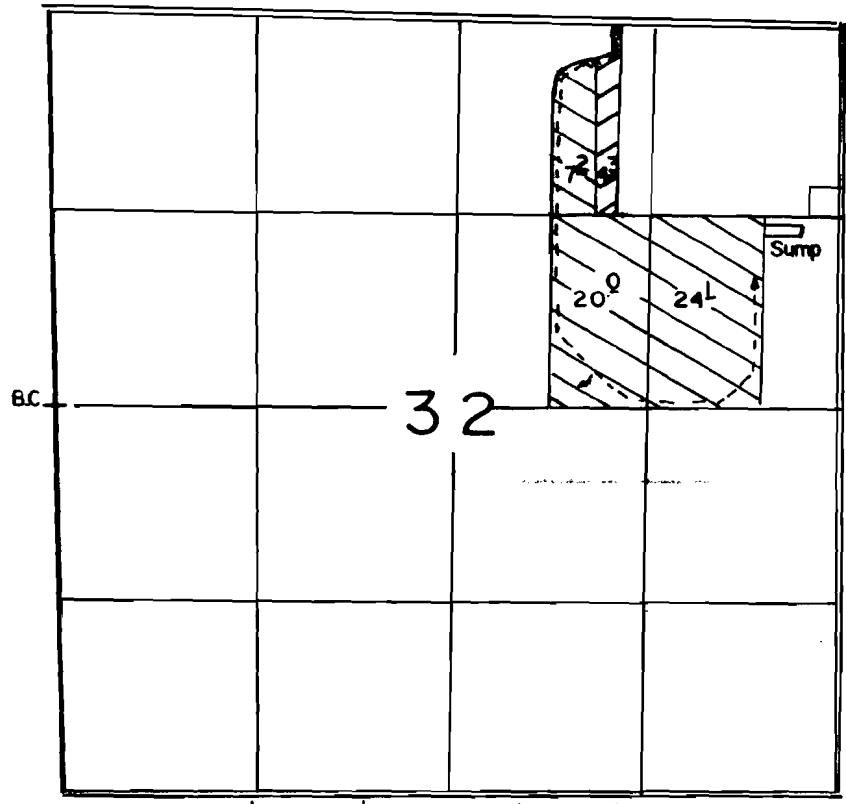

Sump Loc 1250'N & 400'W From E1/4 Corner Section 32

SCALE: 1"=1320'

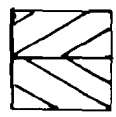

Transfer 4217
Permit G-9721

FINAL PROOF SURVEY UNDER

Transfer 4217

Application No. G-10601.. Permit No. G-9721.....
IN NAME OF

.....JIM.....STEWART.....

Surveyed OCT...17.... 19.87., by J.M.WARREN.....