
T. 8 S., R. 2 & 3 W., W.M.

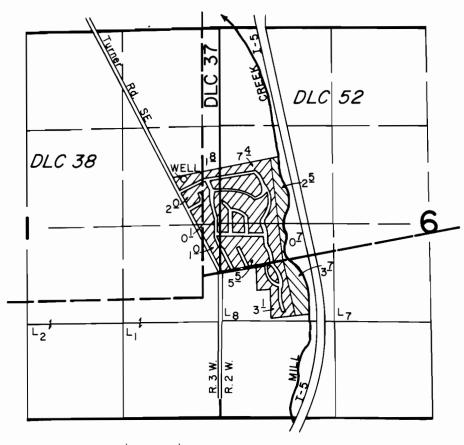

WELL LOC.: 1320'N. 8. 250'W. FROM S.W. CORNER D.L.C. 37

SCALE: 1"= 1320'

FINAL PROOF SURVEY

UNDER



Application No. G-11568, Permit No. G-10737...
IN NAME OF

WARREN POOLE

Surveyed JULY 20, 1988, by Z. F. SALEH

Acreage Shown As Primary Represents 60% Of The Land As Irrigated. 40% Covered By Mobile Homes.