




T. 6 N., R. 10 W., W.M.

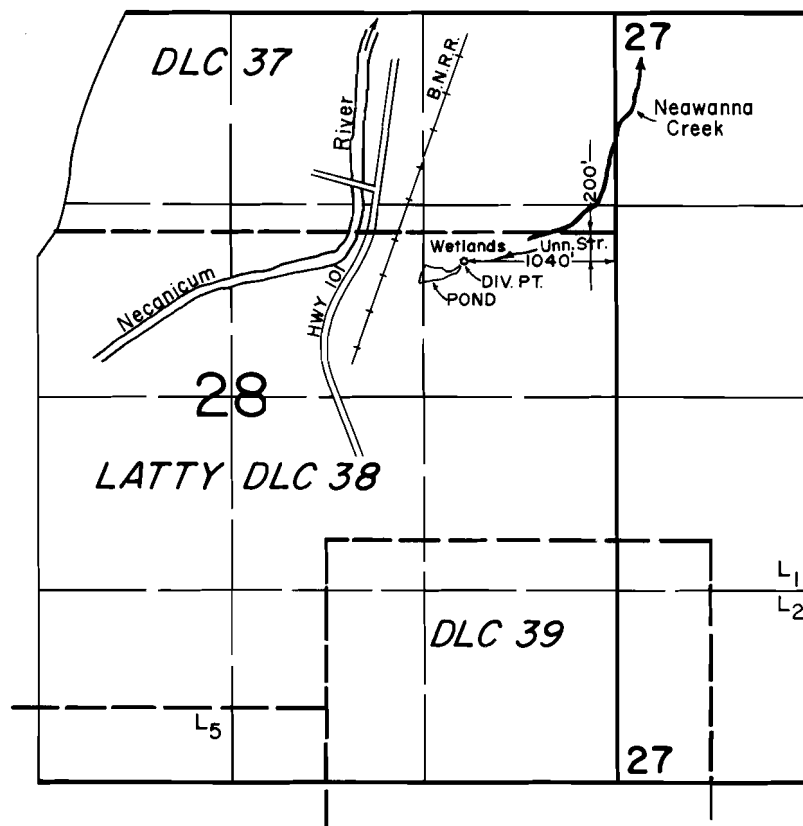

SCALE: 1" = 1320'

FINAL PROOF SURVEY UNDER

R-52612

R-6265

Application No. 51893... Permit No. 39155.....

IN NAME OF

ROBERT L. & MARJORIE A. STEVENS

Surveyed JUNE 19, 1989, by T.M. WARREN.....