


T.2N., R.4W., W. M.

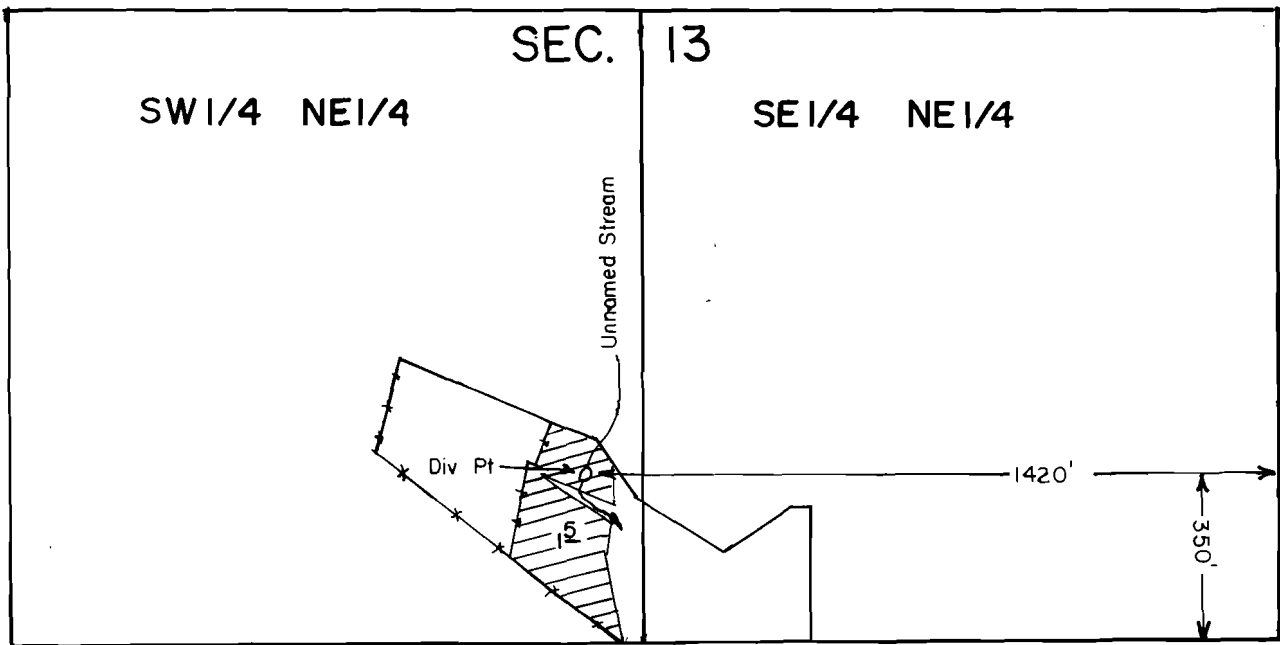

SCALE: 1" = 400'

FINAL PROOF SURVEY UNDER

Application No. 54602... Permit No. 40971.....
IN NAME OF

.....**BRIAN L. & NANCY S. BIEHL**.....

Surveyed JULY 10... 1989., by T.M. WARREN.....