



SCALE 1" = 1320'


T. 1S., R. 34E., W.M.

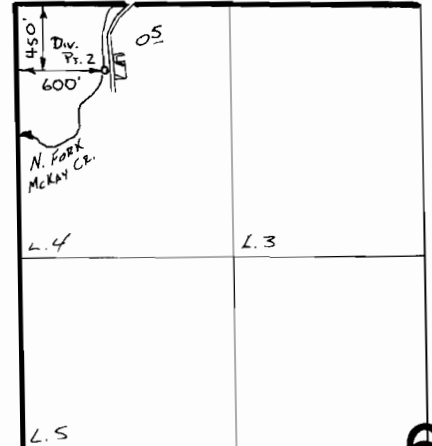

T. 1S., R. 33E., W.M.

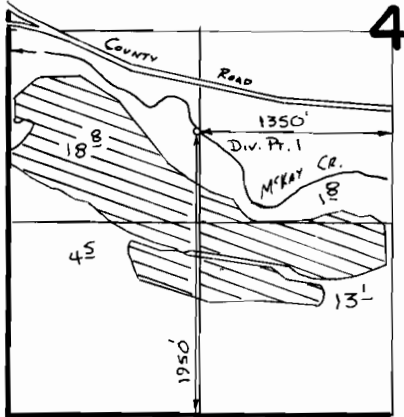

T. 1S., R. 33 & 34E., W.M.

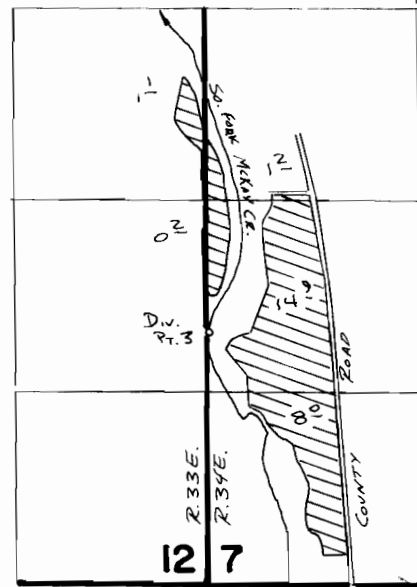

Div. Pt. Loc: 1740' N. & 20' E. From SW. Cor. Sec 7.

FINAL PROOF SURVEY

UNDER

Application No. **56350** Permit No. **42032**..
IN NAME OF

ANDERSON LAND & LIVESTOCK

Surveyed 12-23..... 1987., by *V.L. Church*.....