




T.5N.,R.8&9 W., W.M.

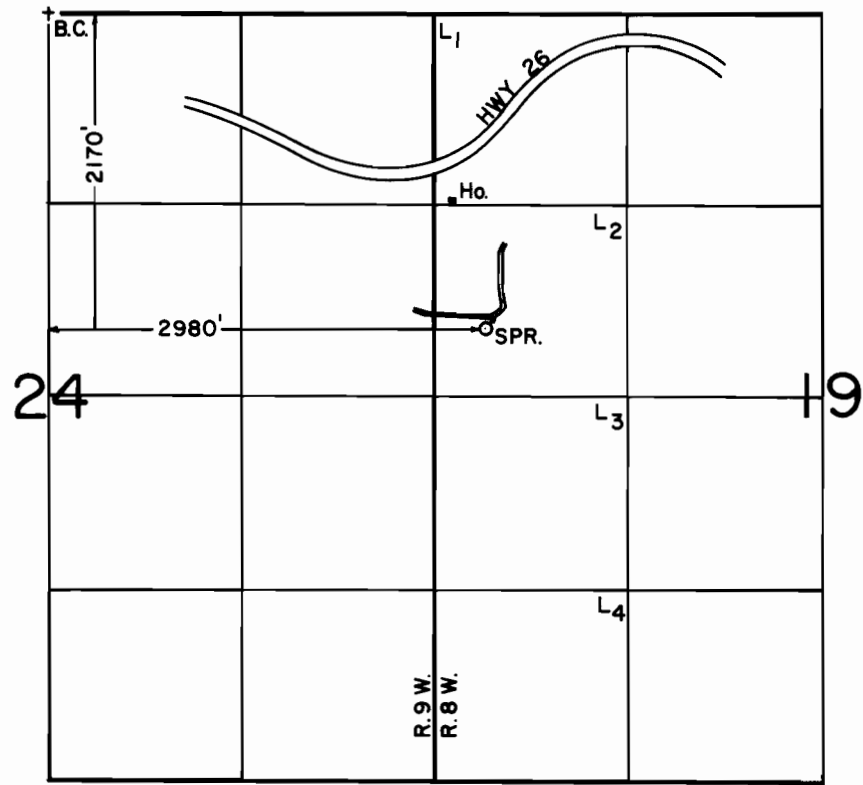

SCALE: 1" = 1320'

FINAL PROOF SURVEY
UNDER

Application No. 56599.. Permit No. 42492.....
IN NAME OF

.....MARVIN L. HAPPEL.....

Surveyed JUNE 19, 1989, by T. M. WARREN...