


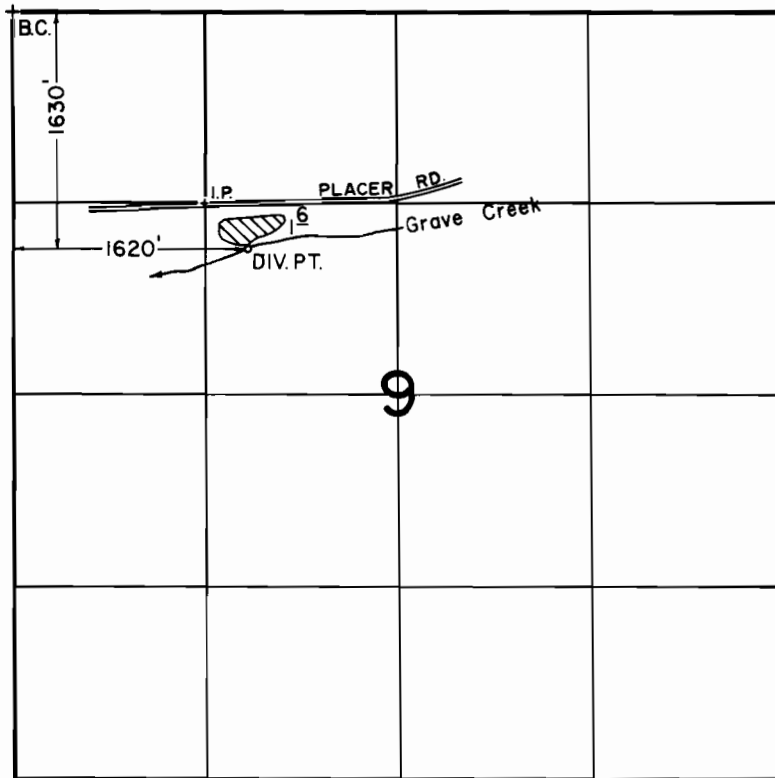

T. 34 S., R. 5 W., W.M.



SCALE: 1" = 1320'

FINAL PROOF SURVEY
UNDER

Application No. 60963... Permit No. 46202.....

IN NAME OF

LOUIS E. HAAG

Surveyed MAY 11... 1989, by B. C. JAMES.....