


T. 38 S., R. 4 W., W. M.

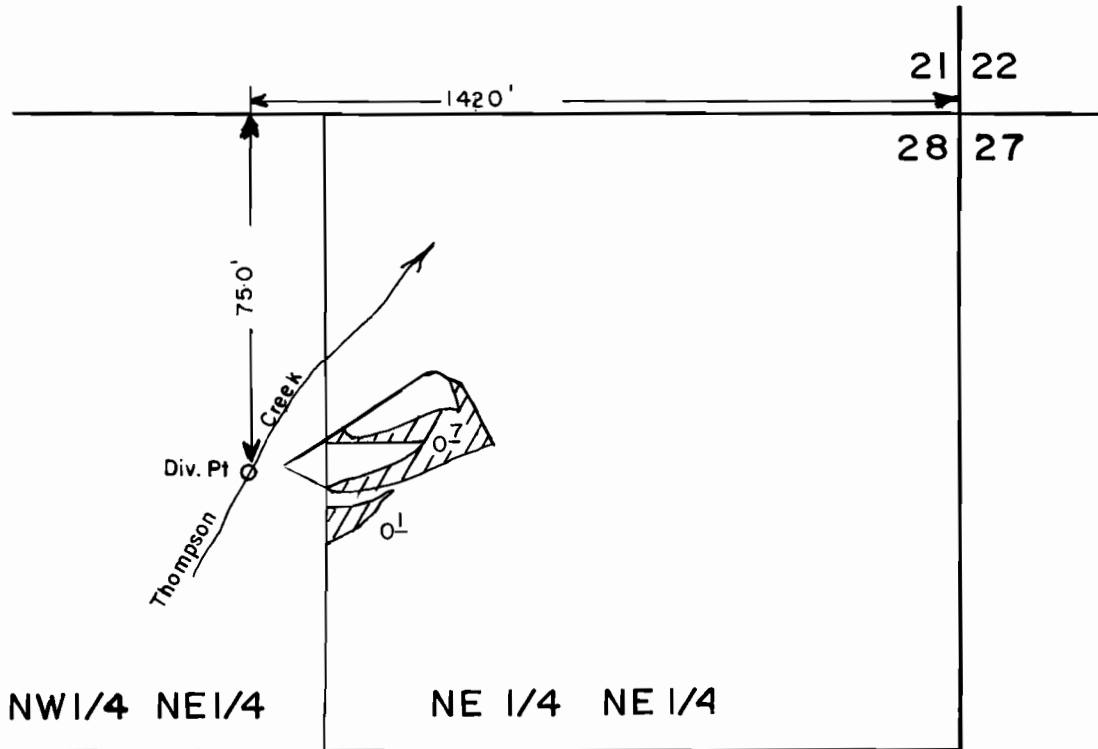

SCALE: 1" = 400'

FINAL PROOF SURVEY
UNDER

Application No. 60273.. Permit No. 46204.....
IN NAME OF

...JOHN E. & MAXINE E. DEYOUNG...

Surveyed JULY 27, 1983., by B.S. JAMES.....