



P-45467
C-63295

T.13S. R.29E. W.M.

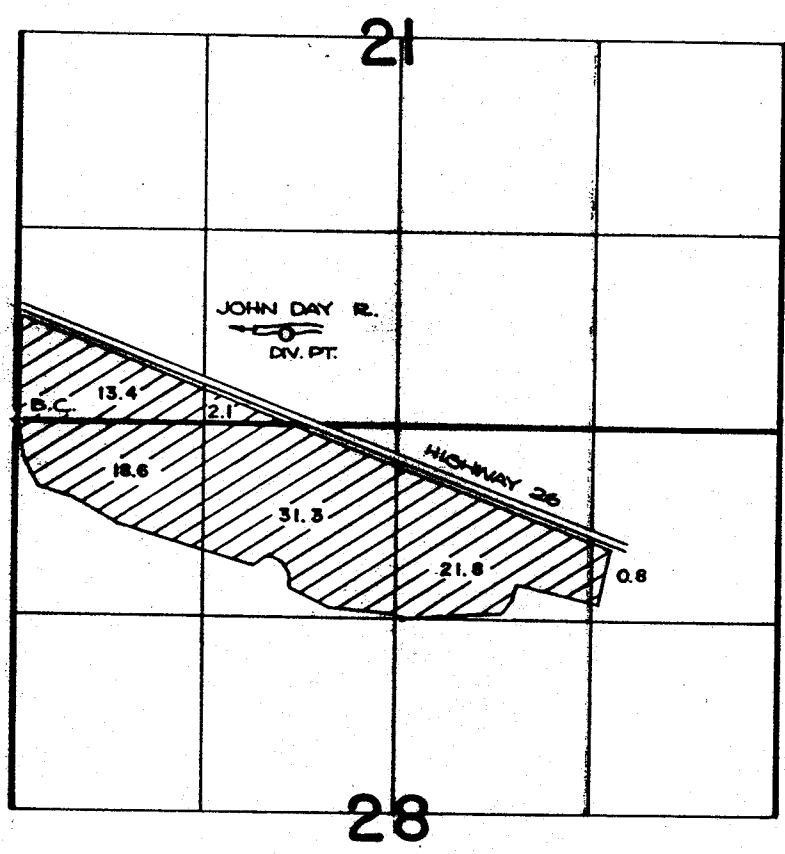

THE DIV. PT. IS LOCATED 500 FT. N. AND 790 FT. W. FROM THE S. 1/4 CORNER OF SECTION 21.

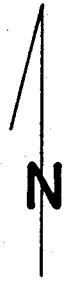

FINAL PROOF SURVEY UNDER

SCALE: 4" = 1 MILE

Application No. 61102... Permit No. 45467...
IN NAME OF

..... DVA

Surveyed AUG. 10... 1981... by P. Patten.....