90684

T. 31 S., R. 15 W., W.M.

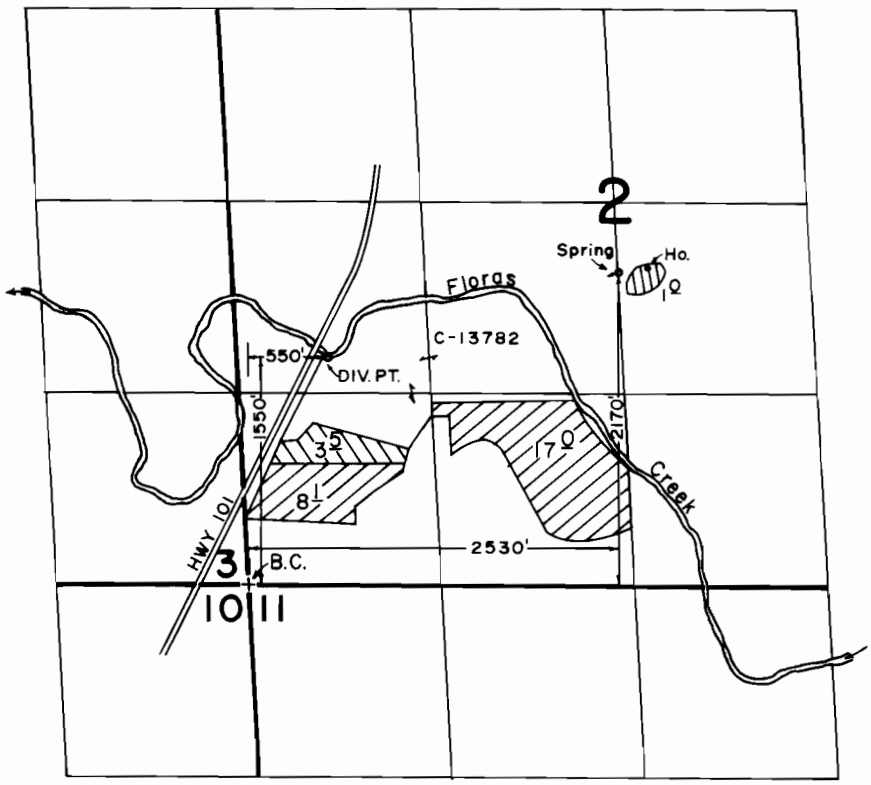

SCALE: 1" = 1320'

FINAL PROOF SURVEY

UNDER

TRANSFER NO. 4544

61260 45551

Application No. 69072 Permit No. 49993

IN NAME OF

LLOYD KREUTZER

Surveyed SEPT. 15 1988, by B. S. JAMES

9-15-89

31S-15W-NE