


T. 37 S., R. 5 W., W.M.

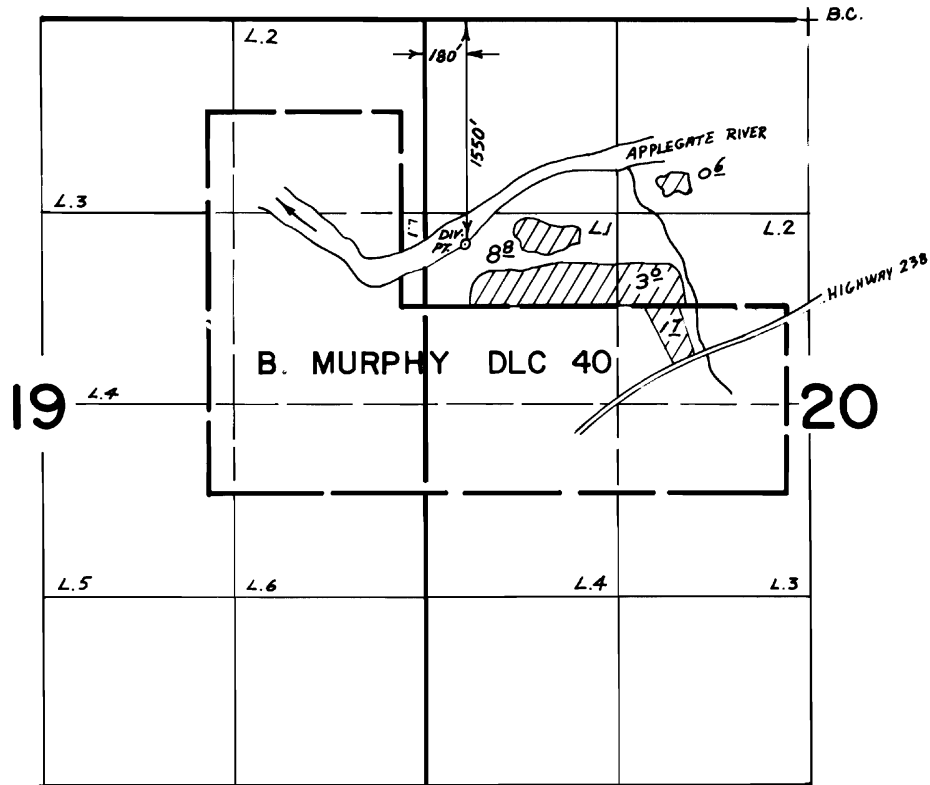

FINAL PROOF SURVEY
UNDER

TRANSFERS 4230 & 4690

Application No. ~~62326~~ Permit No. ~~46416~~.....

IN NAME OF

HARLAN D. WOOD

MICHAEL WOOD & LOIS TRUELSON

Surveyed ~~JUNE 16~~, 1982, by ~~B.R. SUND~~.....

JULY 20, 1983, by B.S. JAMES

SCALE 4" = 1 MILE