
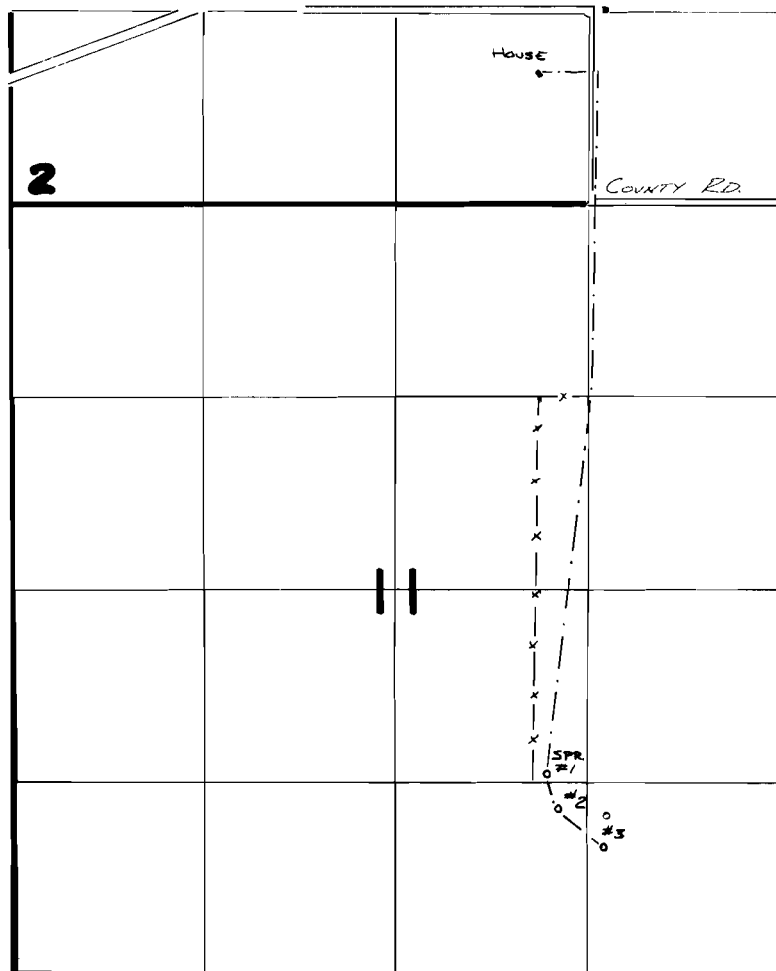


T. 1N., R. 40E., W. M.

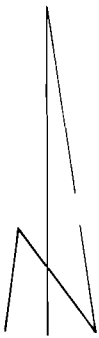

SPRING #1 Loc: 3910'S. & 1620'W.
SPRING #2 Loc: 4140'S & 1550'W.
SPRING #3 Loc: 4420'S & 1230'W. } NE COR. SEC 11


Scale: 1" = 1320'

FINAL PROOF SURVEY
UNDER

Application No. **62957** Permit No. **46686**...
IN NAME OF

.....
Surveyed 4-11..... 1988, by V.L. Church.....