


T.7N.,R.8W.,W M

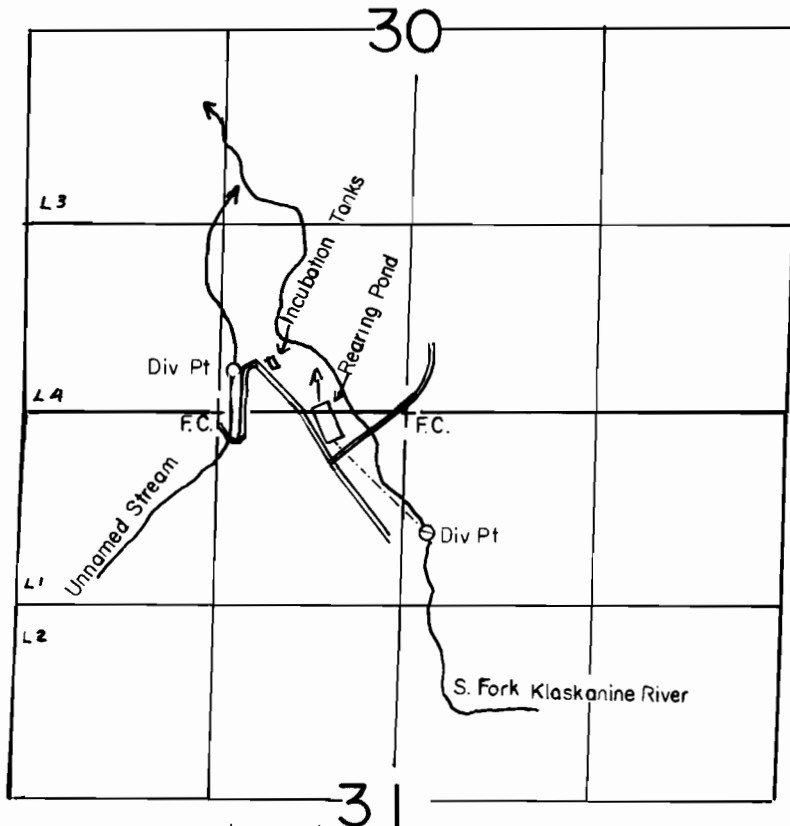

River Div Pt. Loc. 850' S & 150' E., Stream Div Pt. Loc. 300' N. & 1200' W  
Both From N 1/4 Corner Section 31

SCALE: 1"=1320'

**FINAL PROOF SURVEY  
UNDER**

R-59289  
59290  
62991

R-8108  
44782  
46895

Application No. 65209..... Permit No. 47875.....

IN NAME OF

Clatsop County Economic Development Committee  
Fisheries Project

Surveyed JUNE 20, 19....., by I.M. WARREN.....