


T.6S., R.8W., W.M.

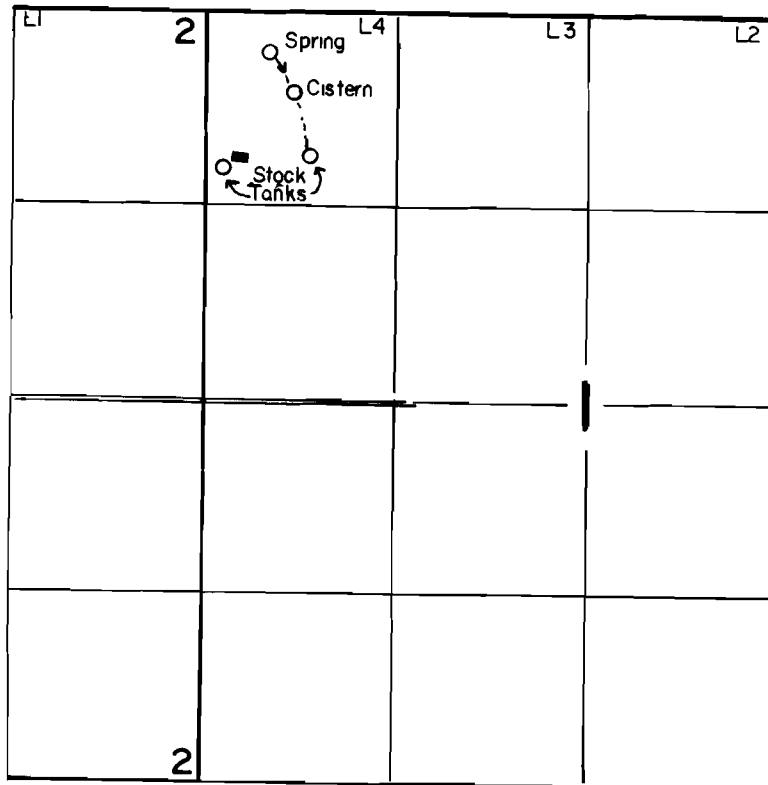

SPRING LOCATED 280'S & 400'E FROM NW CORNER SECTION 1

SCALE: 1" = 1320'

FINAL PROOF SURVEY
UNDER

Application No. 63024 Permit No. 46803

IN NAME OF

ELMER O. POND

Surveyed MAY 8, 1989, by T.M. WARREN