




T. 2 N., R. 2 W., W.M.

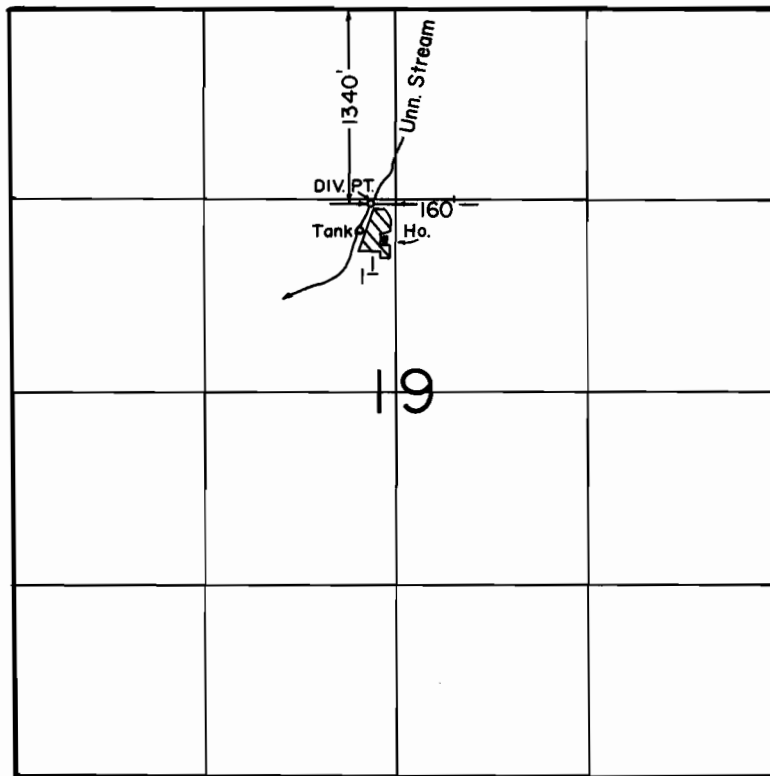

SCALE: 1" = 1320'

**FINAL PROOF SURVEY**  
UNDER

Application No. 65034.. Permit No. 47784....  
IN NAME OF

..... HARVEY C. ROSE .....

Surveyed JUNE 6... 1989., by T. M. WARREN....