


T.7N.,R.8W.,W M

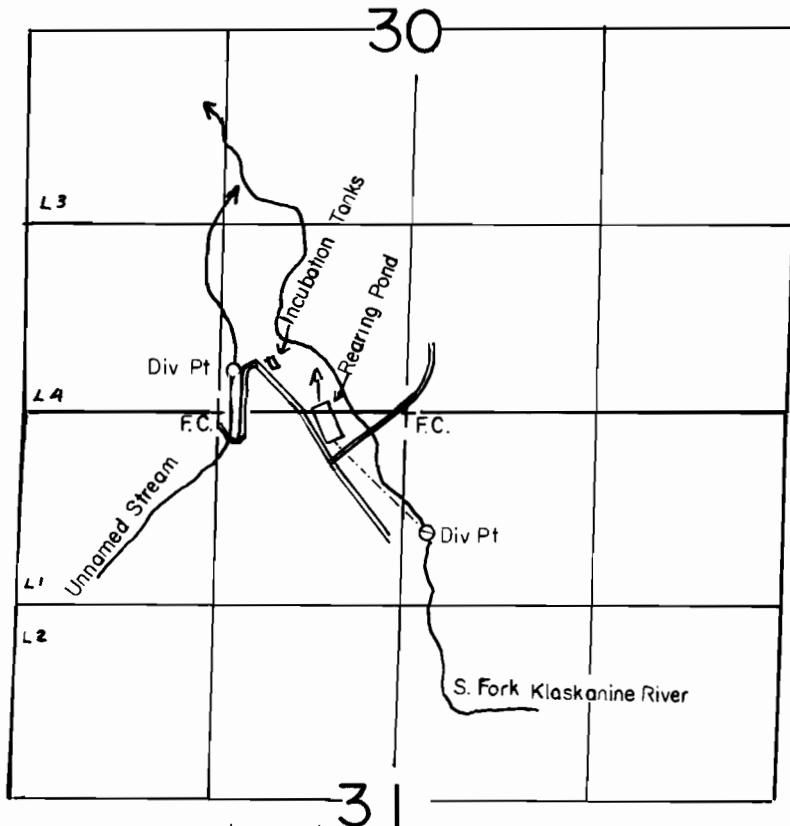

River Div Pt. Loc. 850' S & 150' E., Stream Div Pt. Loc. 300' N. & 1200' W
Both From N 1/4 Corner Section 31

SCALE: 1"=1320'

FINAL PROOF SURVEY
UNDER

R-59289
59290
62991

R-8108
44782
46895

Application No. 65209..... Permit No. 47875.....

IN NAME OF

Clatsop County Economic Development Committee
Fisheries Project

Surveyed JUNE 20, 19....., by I.M. WARREN.....