


T. 4N., R. 9W., W. M.

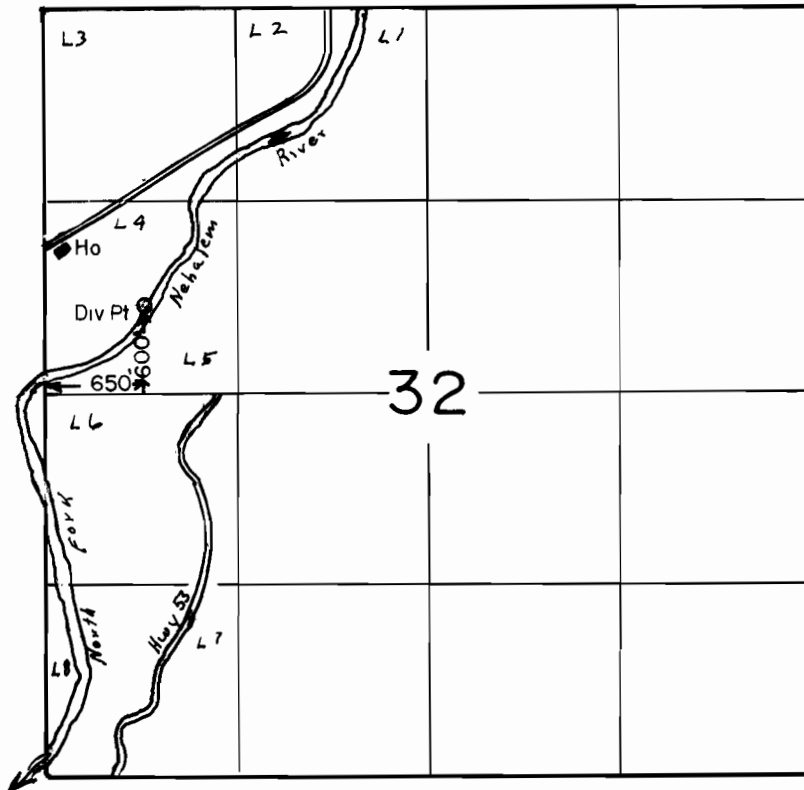

SCALE: 1"=1320'

**FINAL PROOF SURVEY
UNDER**

Application No. 65293..... Permit No. 47916.....
IN NAME OF

CHARLES J. & SHIRLEY L. SCHUBERT

Surveyed JUNE 21, 1989, by T. M. WARREN