


RECEIVED

NOV 16 1983

WATER RESOURCES DEPT.
SALEM, OREGON

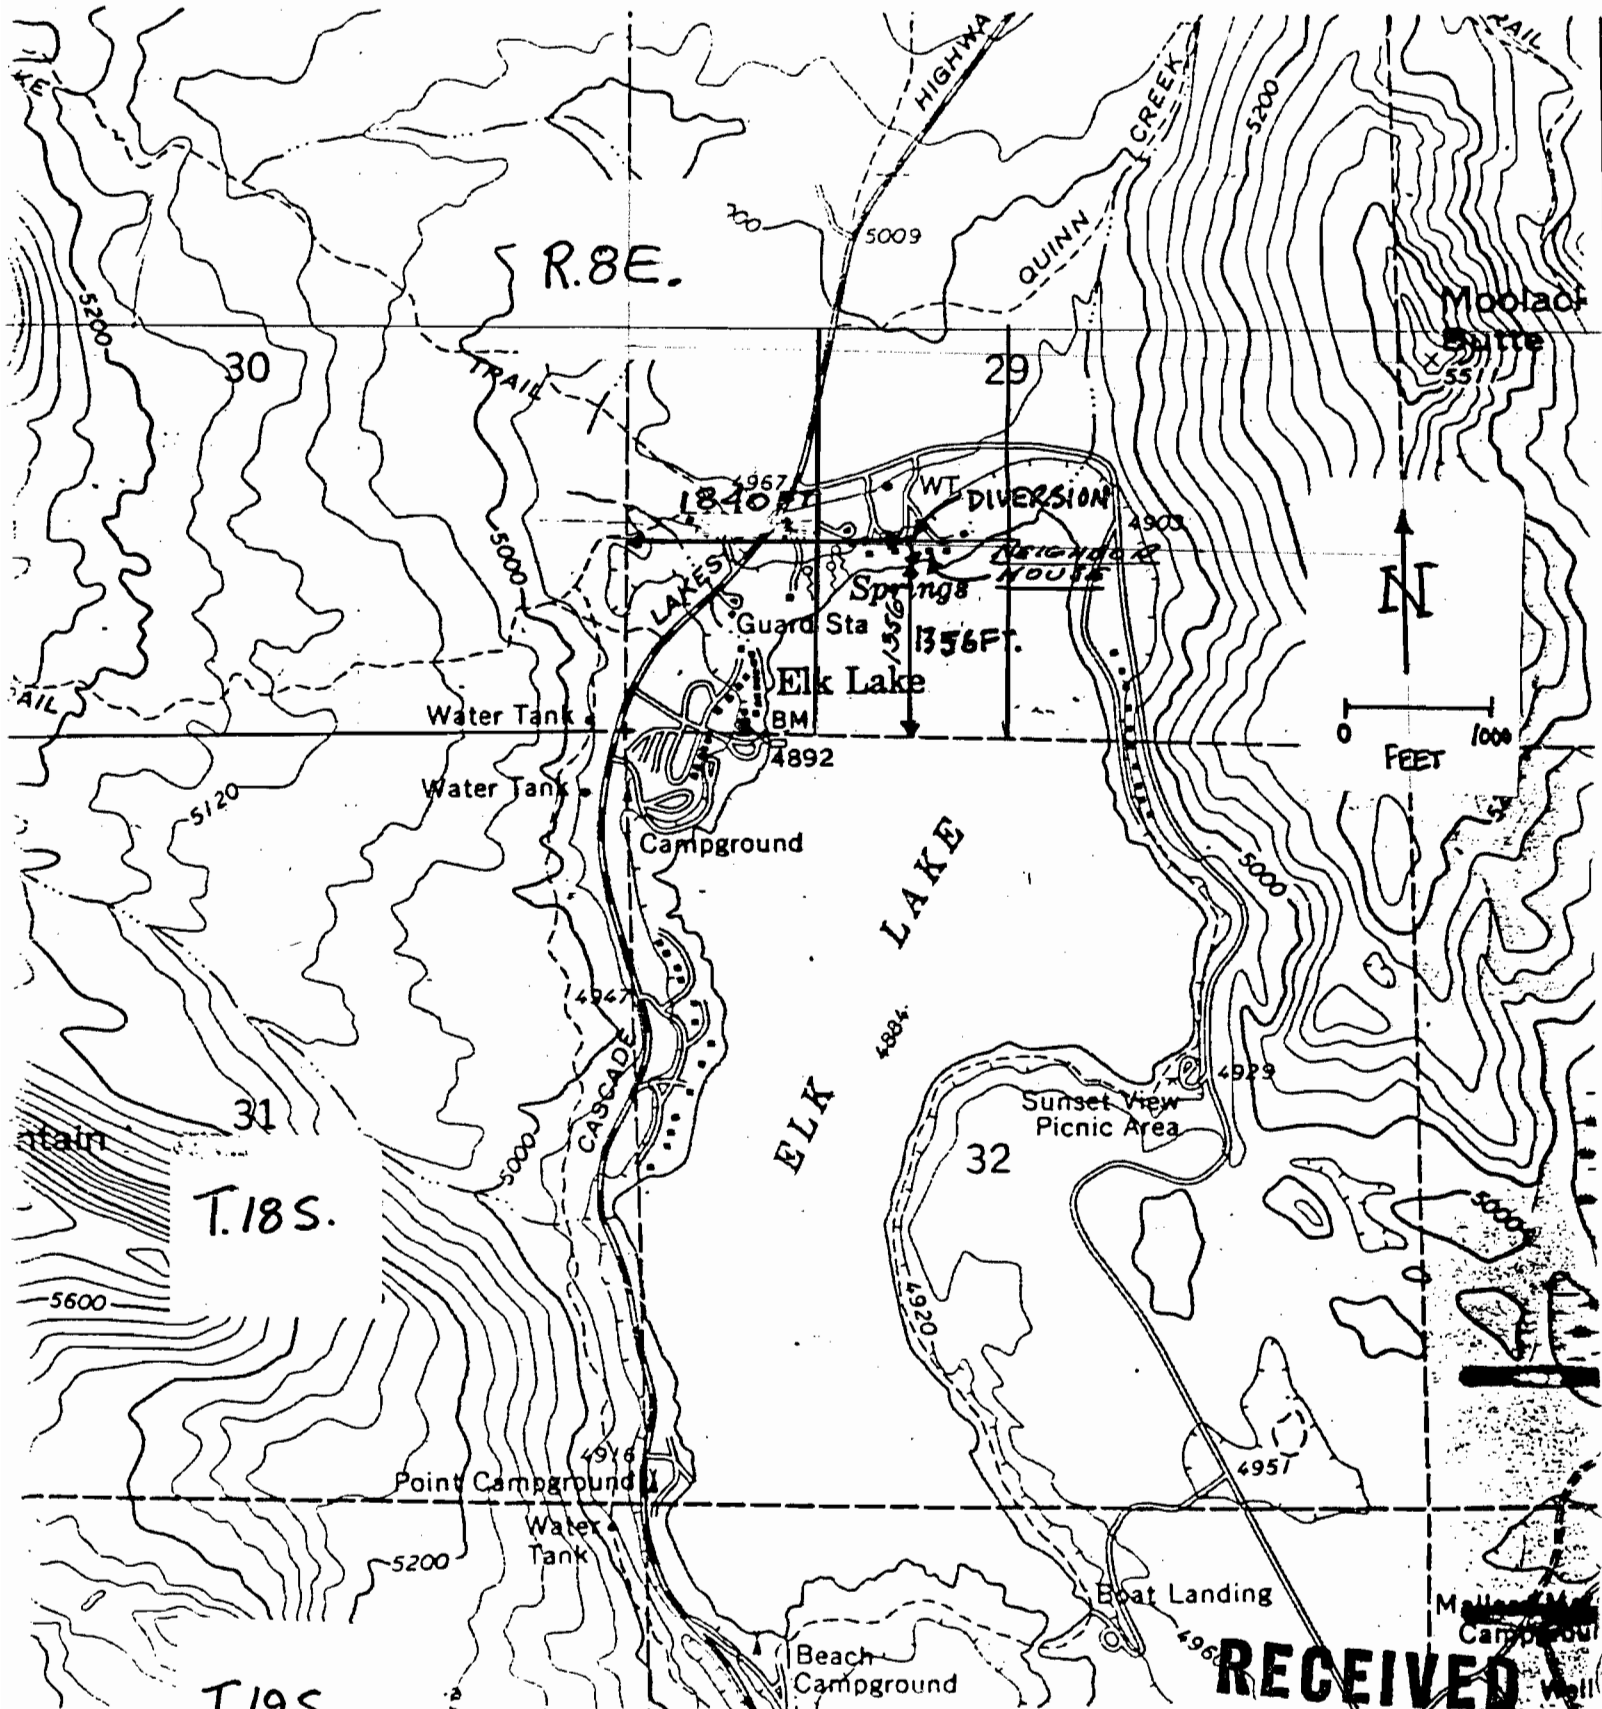

Application No. 65988
Permit No. 48040

RECEIVED

SEP 8 1983

WATER RESOURCES DEPT.
SALEM, OREGON