




T. 31 S., R. 15 W., W.M.

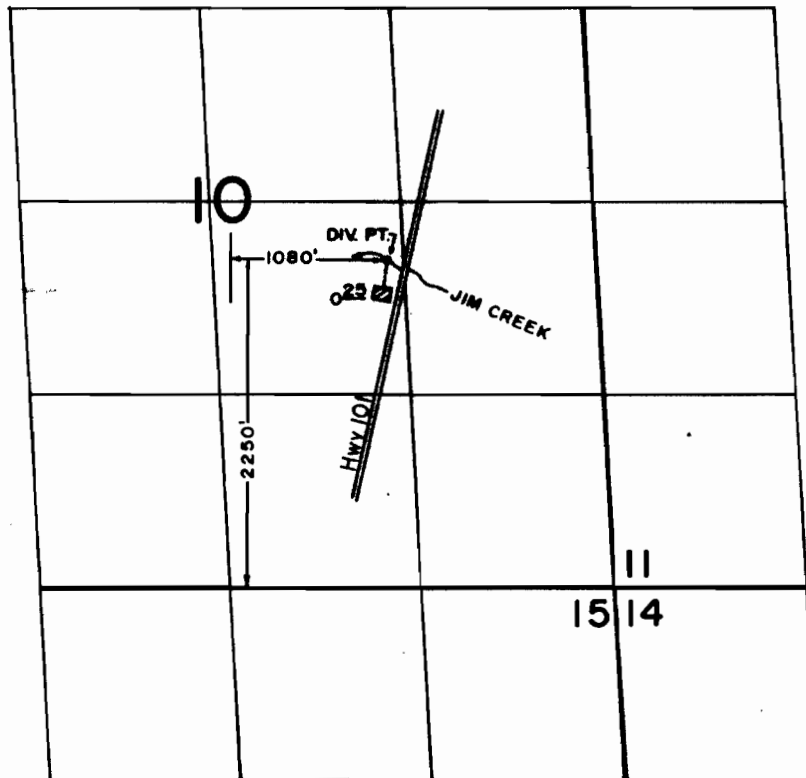

SCALE: 1" = 1320'

FINAL PROOF SURVEY
UNDER

Application No. 66027.. Permit No. 48334.....
IN NAME OF

VICTOR D. FARRIS.....

Surveyed JUNE 24 1988., by ...B.S. JAMES.....

9-19-89
31S-15W-NE