


T. 2N., R. 3W., W.M.

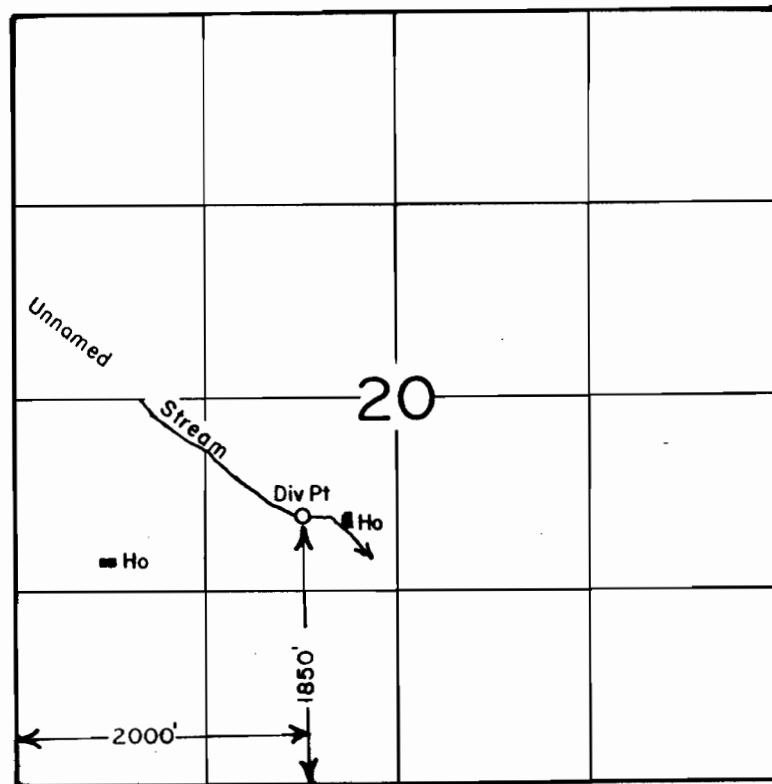

SCALE: 1" = 1320'

FINAL PROOF SURVEY
UNDER

Application No. 67978... Permit No. 48456.....
IN NAME OF

MARK A. COUSSENS & ARNOLD COLWELL

Surveyed JULY 12... 1989, by T.M. WARREN.....