


T. 6 S., R. 8 W., W.M.

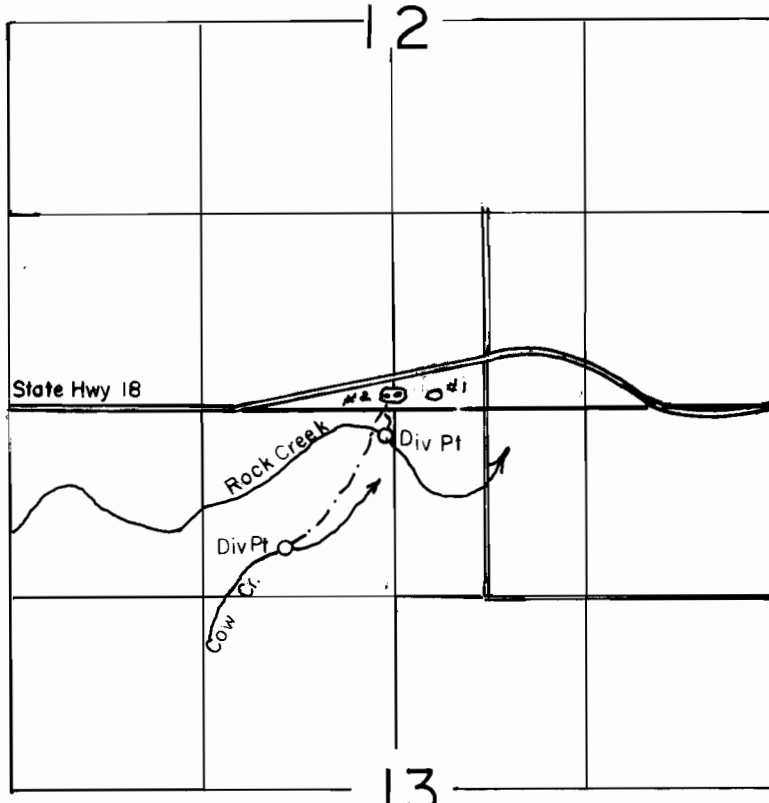

Div Pts. Located, Rock Cr. 200' S & 2600' E, Cow Cr 950' S & 1950' E, Both From NW Corner Section 13

SCALE: 1" = 1320'

FINAL PROOF SURVEY
UNDER

R -68143 R -10024

Application No. 68144.... Permit No. 48878.....

IN NAME OF

.....**CARL ANDERSON**.....

Surveyed JULY 5..... 1989., by J.M. WARREN.....